


T.22S. R. 6W.W.M.

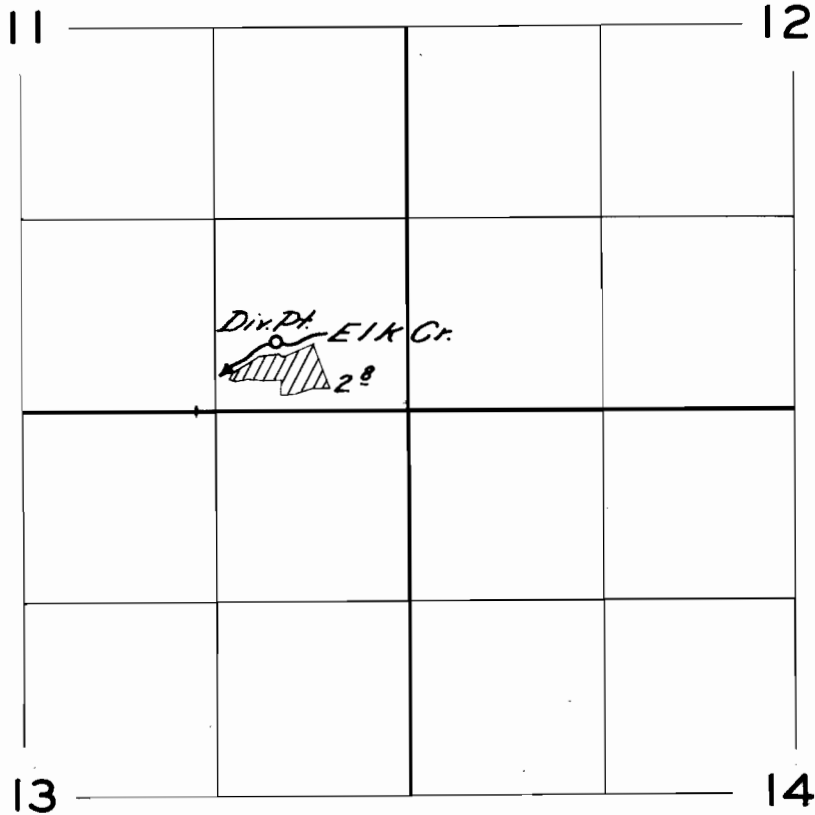

**FINAL PROOF SURVEY**

UNDER

Application No. *26216* Permit No. *20600*

IN NAME OF

.....*Roy M. Jones*.....

Surveyed *June 28 1956*, by *C. O. Bartels*