


# T.24S.R.7W.W.M

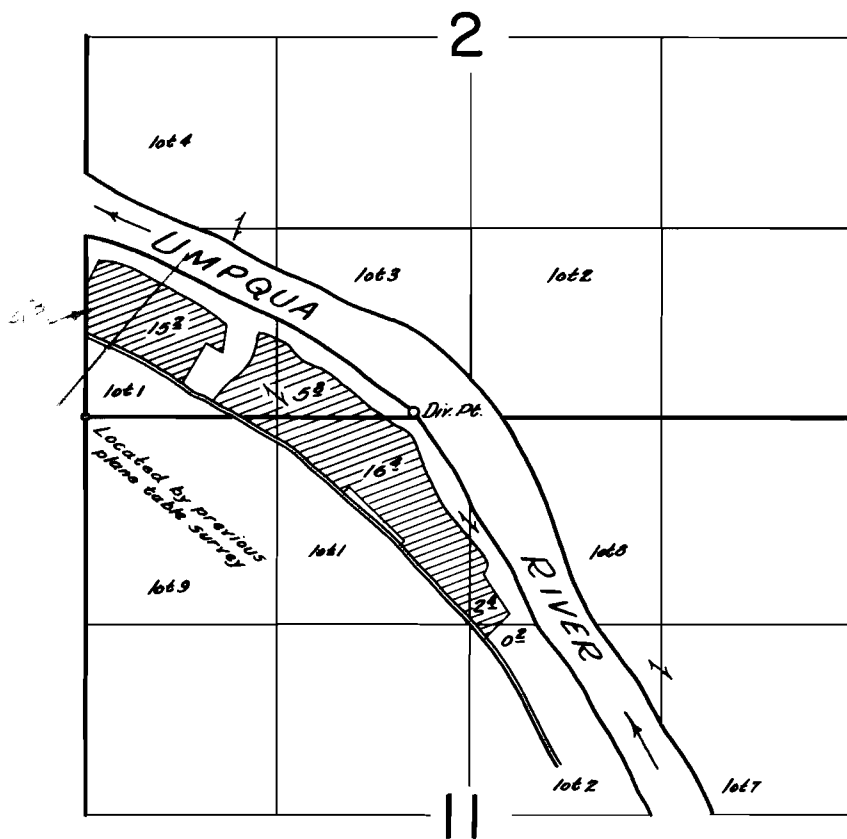


## FINAL PROOF SURVEY UNDER

Application No. 32563 Permit No. 25778  
IN NAME OF

Milo Bullock

Surveyed April 10 1963, by C.O. Bartals

# T.24S., R.7 W., W.M.

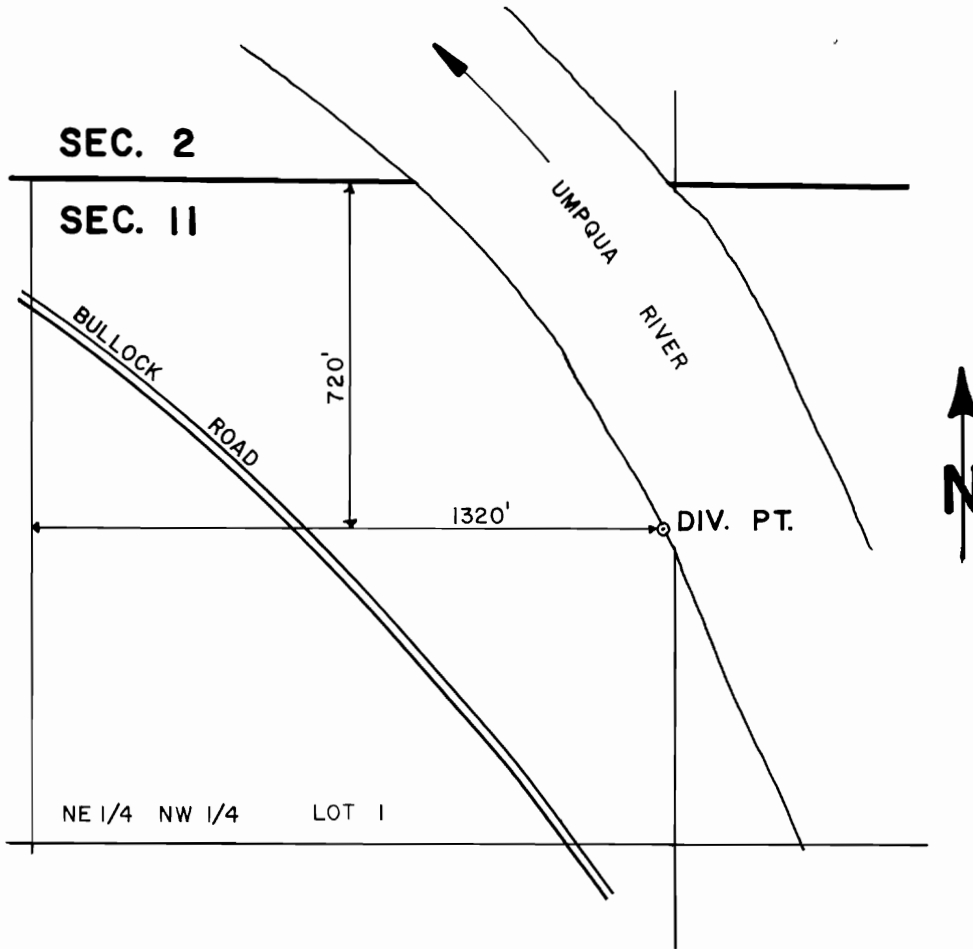

SCALE: 1" = 400'

## FINAL PROOF SURVEY UNDER

TRANSFER NO. 4862 OLD CERTIFICATE NO. 46546

IN NAME OF

**EDWARD C. KERN**

Surveyed AUG. 20 1986, by J. M. SCHMORDE