


T. 2S. R. 22E. W.M.

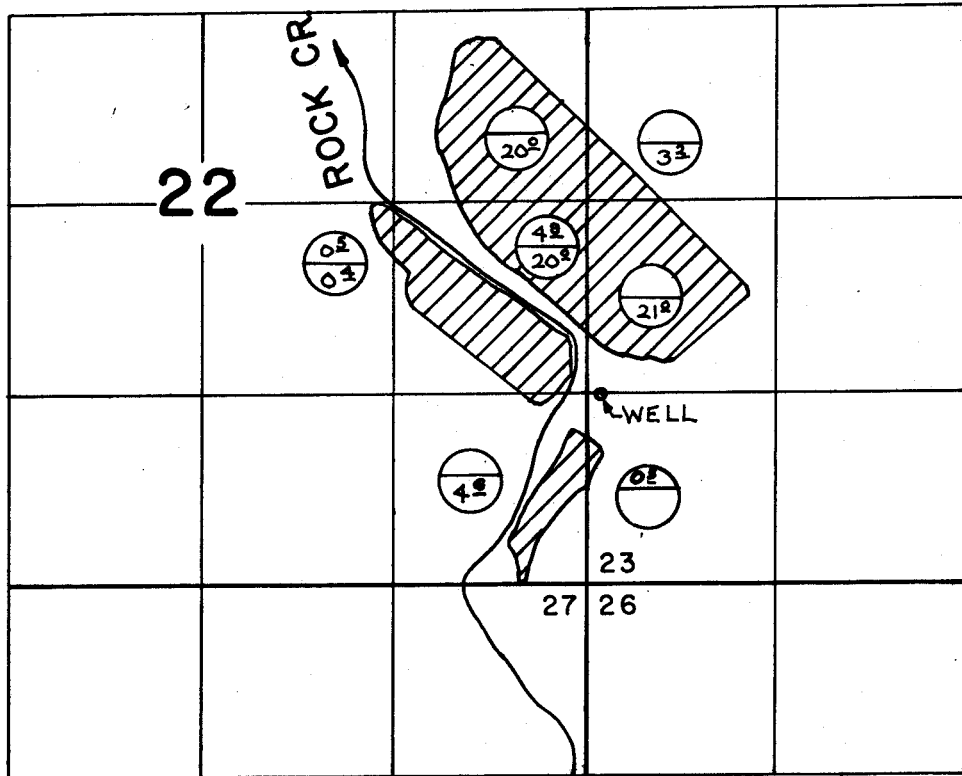

WELL LOC. - 1320' N. + 80' E. FROM S.E. CORNER SEC. 22

 PRIMARY
 SUPPLEMENTAL

FINAL PROOF SURVEY UNDER

Application No. G-5430 Permit No. G-5356
IN NAME OF

DALE BEAMER

Surveyed July 21, 1976, by R.G. Mucken