


G-6140

46550  
37917

# T.5S.R.23E.W.M.

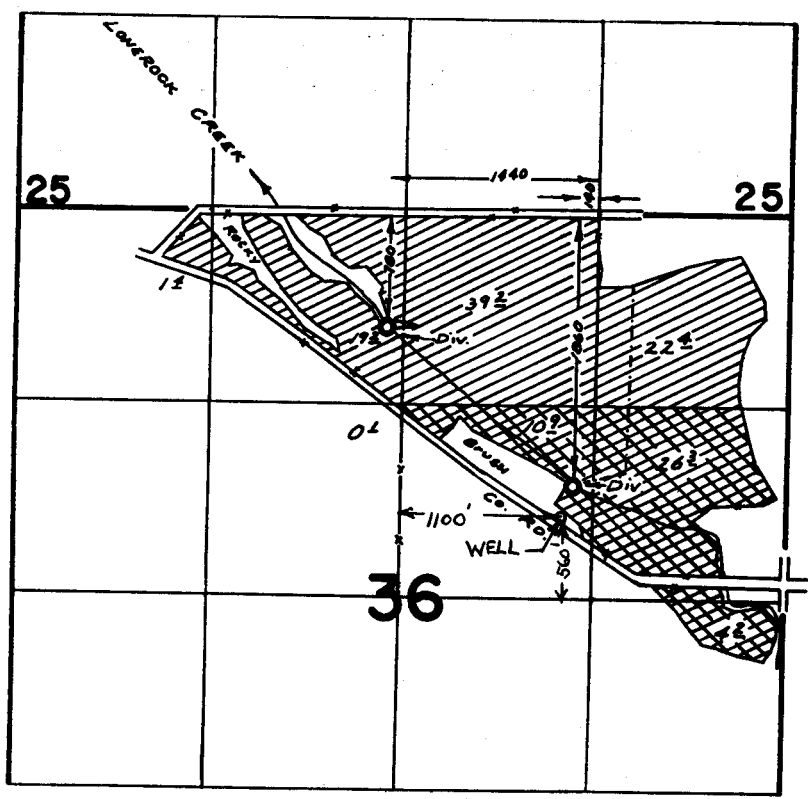

## FINAL PROOF SURVEY

UNDER

G-6532

G-6140

Application No. 45078 Permit No. 33691

IN NAME OF

**PETER O. CAMPBELL**

Surveyed Oct. 27 1970, by R. MUGGEN

