


T.25S., R.33E., W.M.

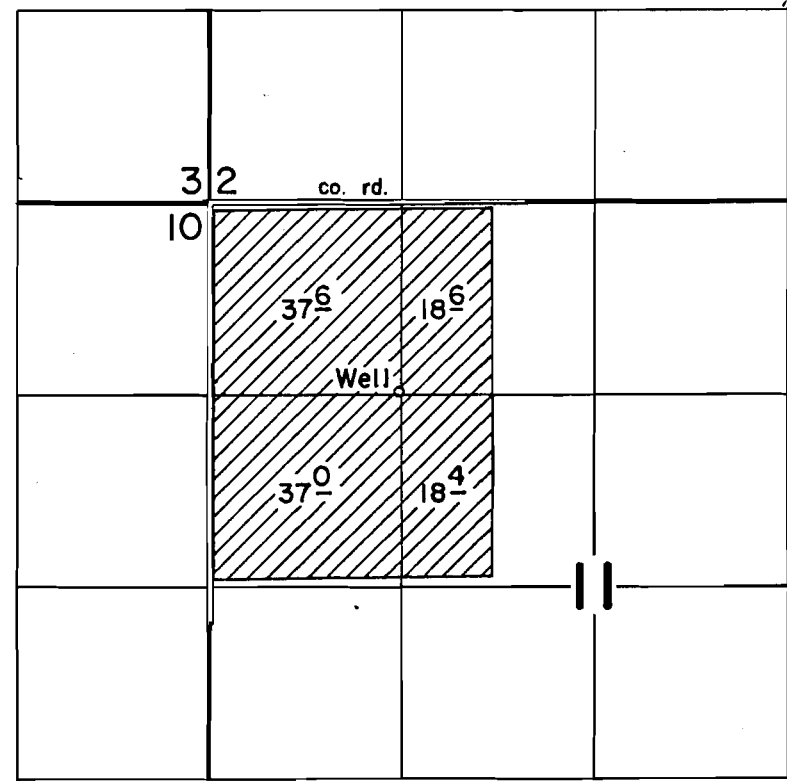

Well Loc: 1300' S & 1300' E from NW cor. section 11

FINAL PROOF SURVEY UNDER

Application No. G-7175 Permit No. G-6374
IN NAME OF

JOHN T. RANKIN

Surveyed April 24 1976, by D. Norby