


T. 35 & 36 S. R. 1 E. W. M.

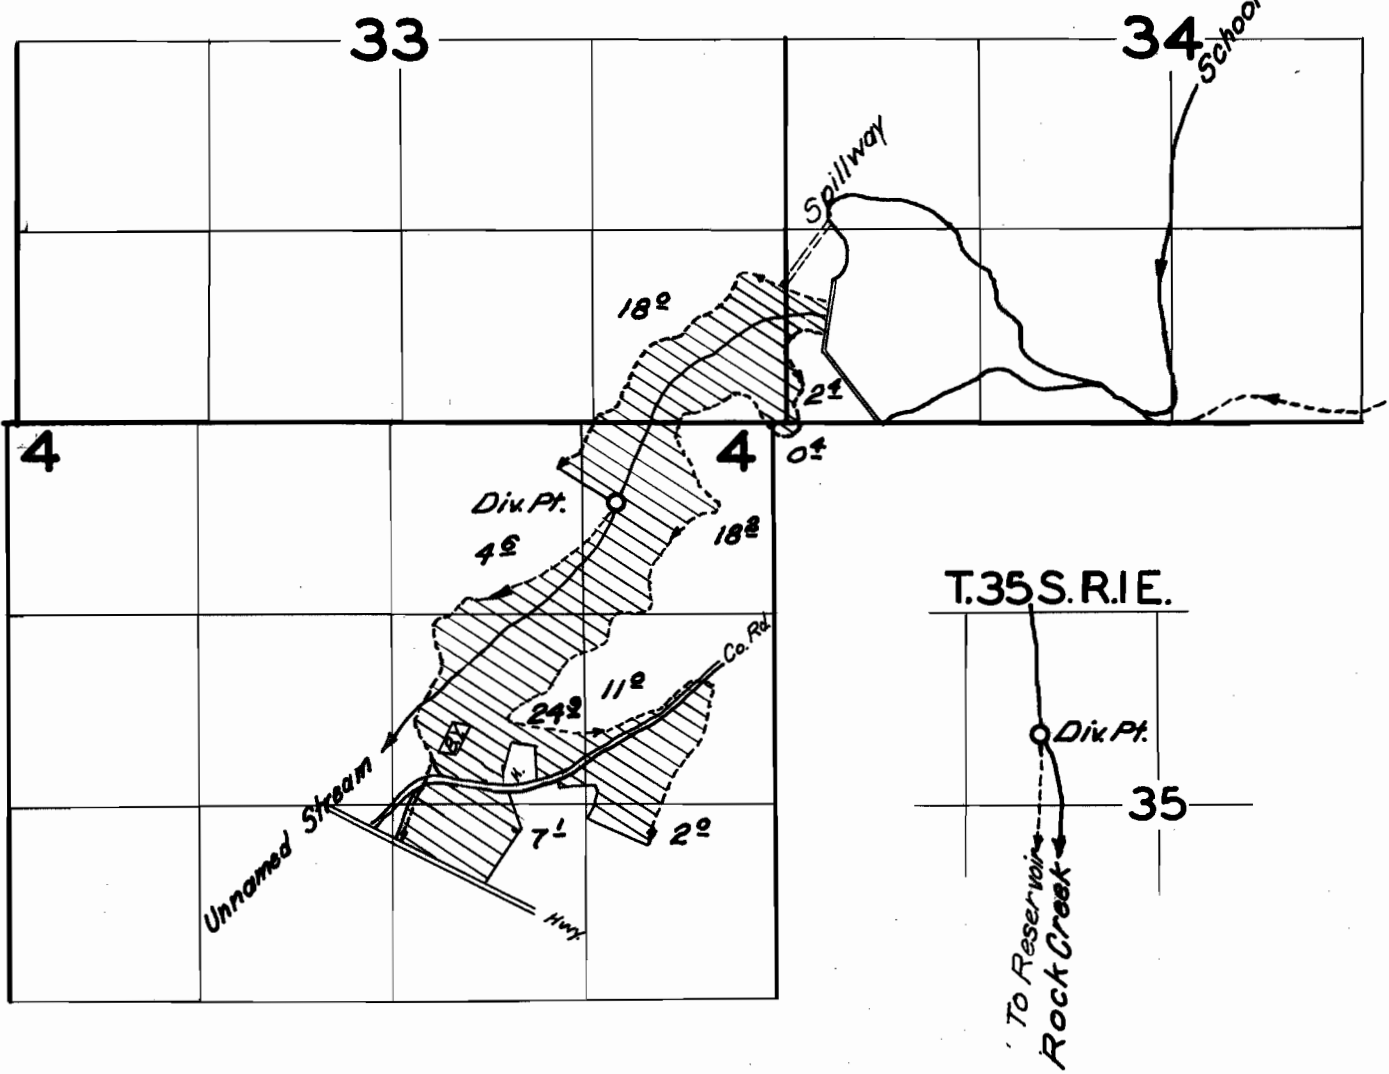

FINAL PROOF SURVEY

UNDER

R-29221
29222
R-30511

R-1662
23116
R-1828

Application No. 30512 Permit No. 24023

IN NAME OF

Ira V. Woolfolk

Surveyed 11 Apr. 1962, by Carl R. Baker