


T. 39S. R. 18E. W.M.

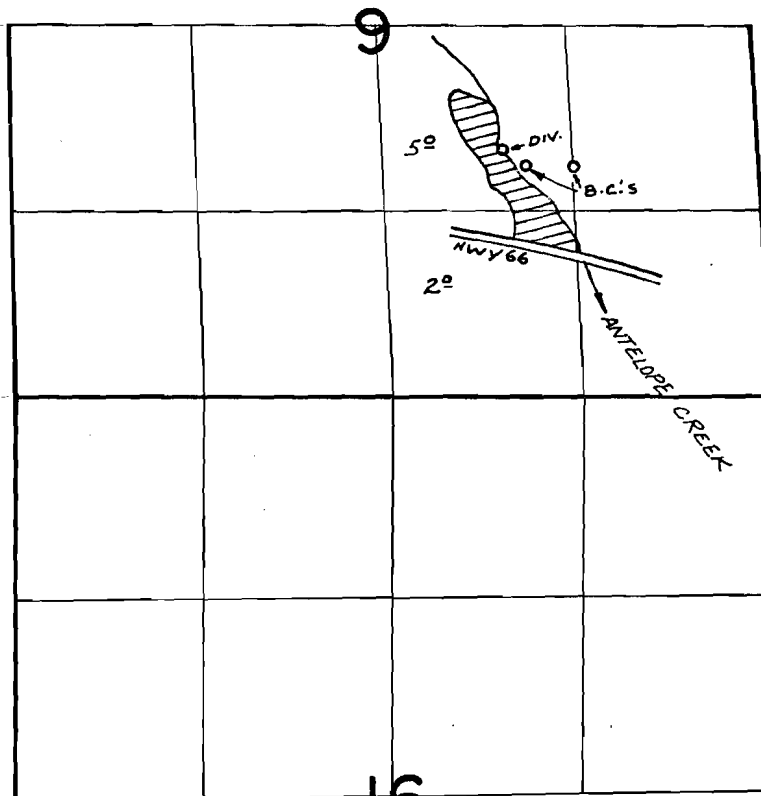

DIV. LOC: 420' N. & 500' W. FROM S.E. COR. NW $\frac{1}{4}$ SE $\frac{1}{4}$ SEC. 9

FINAL PROOF SURVEY
UNDER

Application No. 50983 Permit No. 37431
IN NAME OF

FLOYD MATLOCK

Surveyed OCT. 23, 1976, by R. MUCKEN