
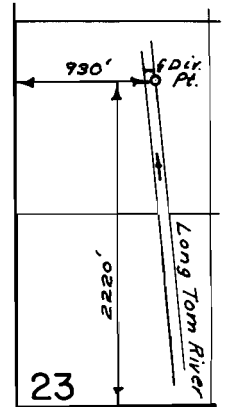


T. 15 S., R. 5 W., W.M.

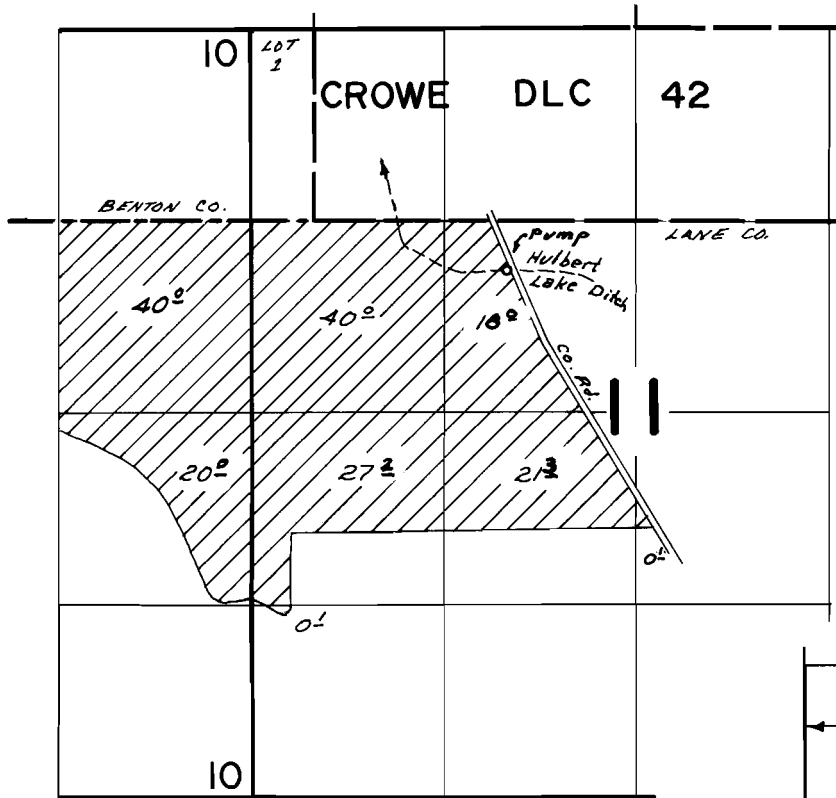

FINAL PROOF SURVEY UNDER

T. 15 S., R. 5 W.

Application No. 44563 Permit No. 33354
IN NAME OF

ROBERT & ROBERTA NIXON

Surveyed May 11, 1976 by D.M. Norby