


T. 15 S., R. 5 W., W.M.

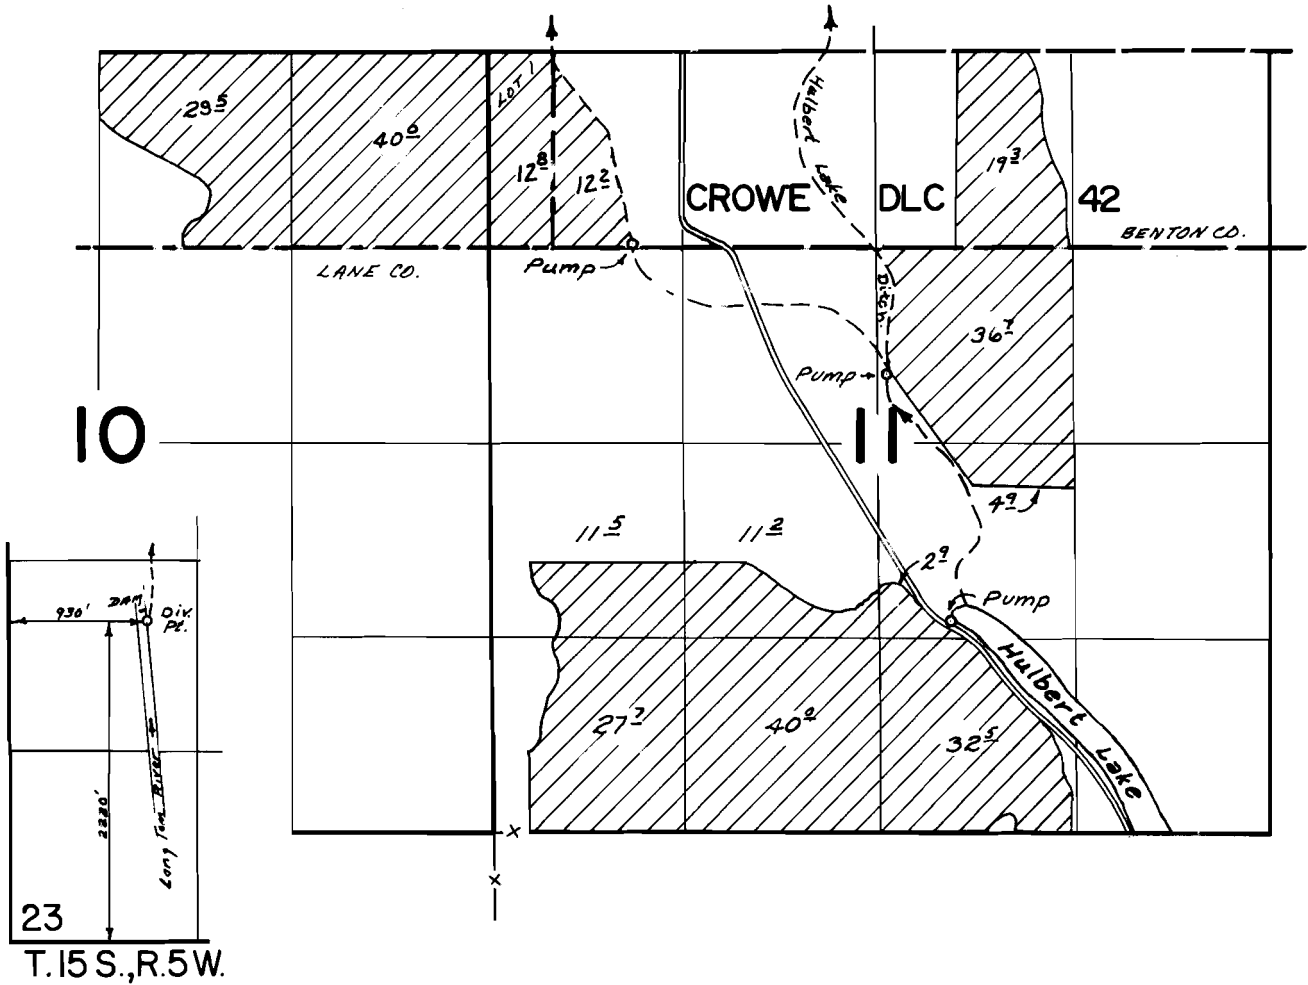

FINAL PROOF SURVEY UNDER

Application No. 44580 Permit No. 33417
IN NAME OF

Bob & Roberta Jean Nixon

Surveyed May 11, 1976, by D.M. Norby