


T. 15 S., R. 1 W., W.M.

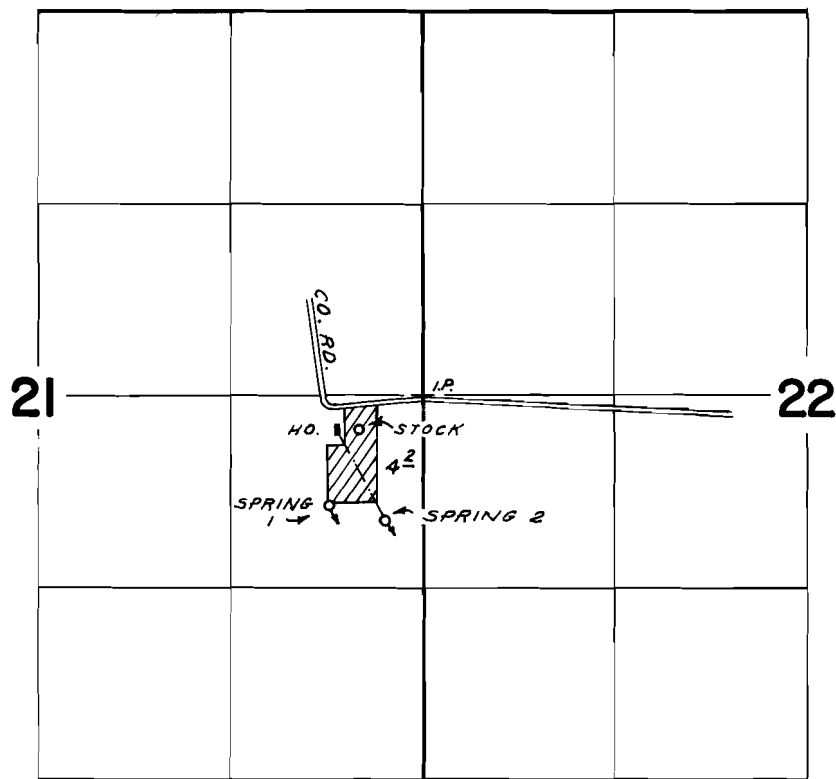

SPRINGS LOC.: #1 - 750'S. & 540'W.; #2 - 860'S.
& 250'W., BOTH FROM E. 1/4 COR. SEC. 21

FINAL PROOF SURVEY
UNDER

Application No. 48298 Permit No. 36268
IN NAME OF

Harold & Theresa Duncan

Surveyed Oct. 22, 1976, by D.M. NORBY