


G-5514
46584

T.39S. R.19E. W.M.

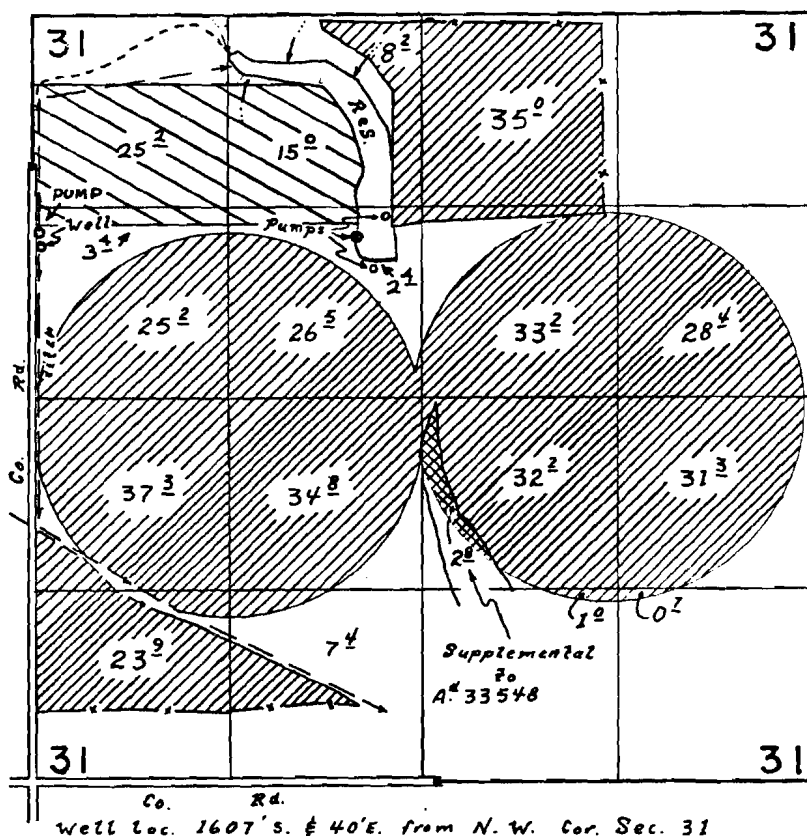

Supplemental
Primary

FINAL PROOF SURVEY UNDER

G-5705

G-5514



Application No. G-5101 Permit No. G-4812
IN NAME OF

Clyde W. Fenimore

Surveyed 18 Sept. 1972, by L.E. Gould
Oct. 23, 1976 R.G. Mucken

DHM
CHZ-SKK-100
1972-U 250