


T.14 S., R.9 W., W.M.

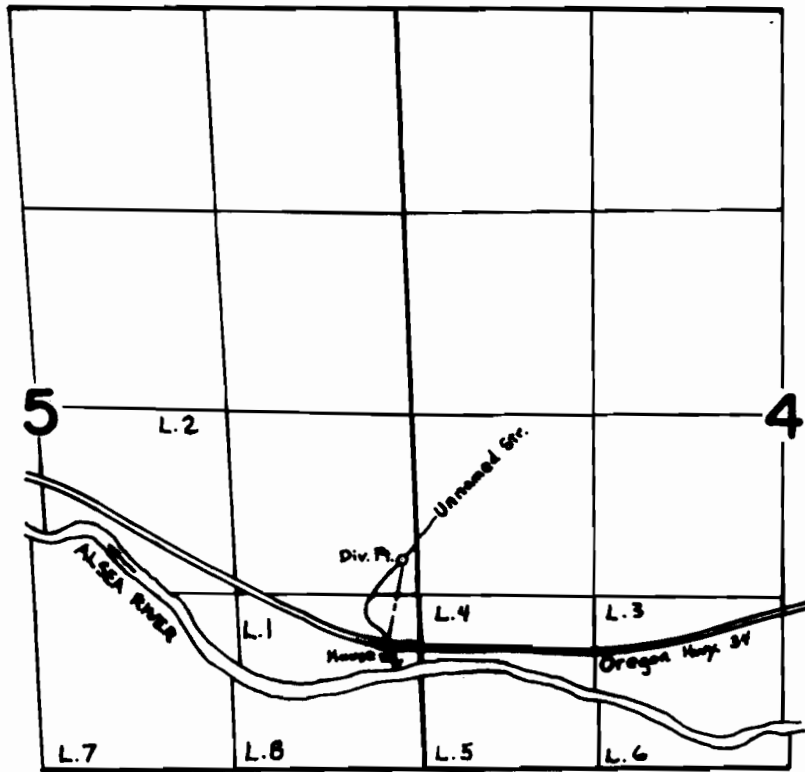

Div. Pt. Located: 240' N 100' W from NE cor. L. 1

FINAL PROOF SURVEY UNDER

Application No. 53591 Permit No. 39933
IN NAME OF

JOHN W. HUNTER

Surveyed AUG. 10 1976, by D. NORBY