


T.9&10S., R.2W., W.M.

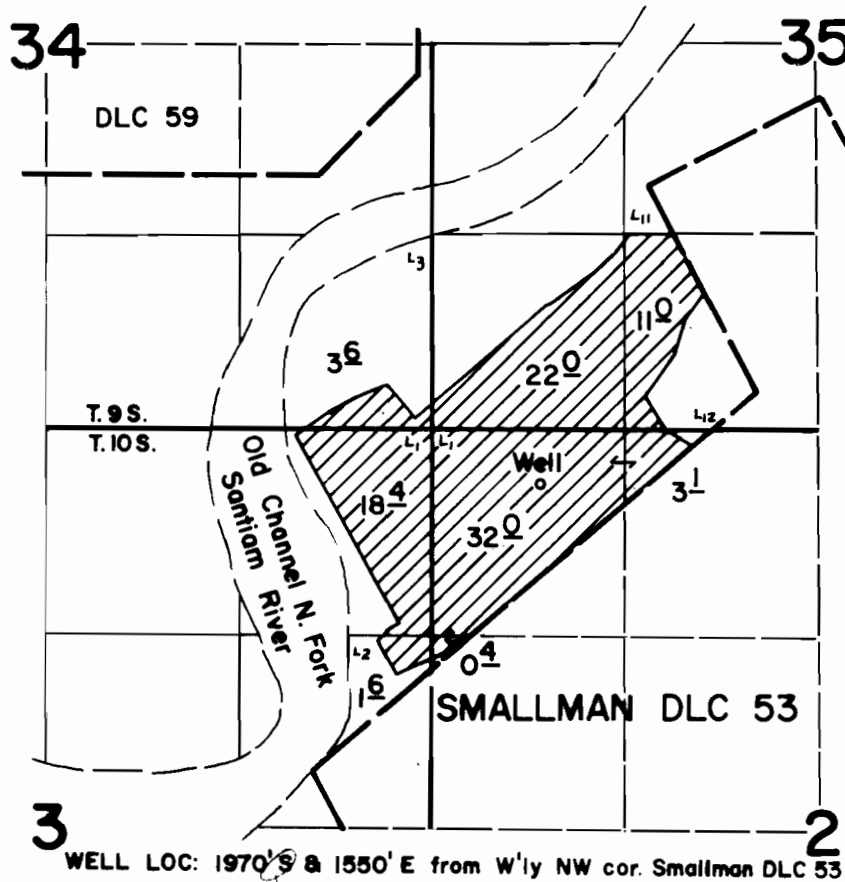

FINAL PROOF SURVEY
UNDER

Application No. G-6050 Permit No. G-5678
IN NAME OF

WALTER D. & PATRICIA R. MILLER

Surveyed Mar. 31 1976, by D. Norby