


# T.11S., R.3W., W.M.

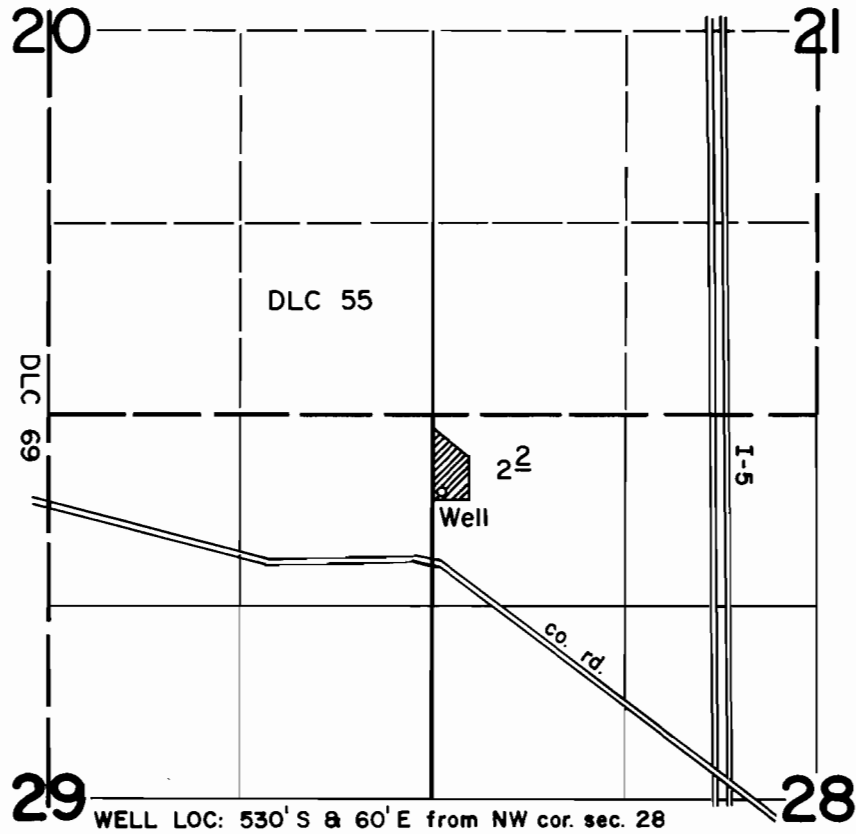

## FINAL PROOF SURVEY UNDER

Application No. G-6382 Permit No. G-5974  
IN NAME OF

DOUGLAS P & MONA J. JAMES

Surveyed April 13 1976, by D. Norby