


# T.10&11S., R.1W., W.M.

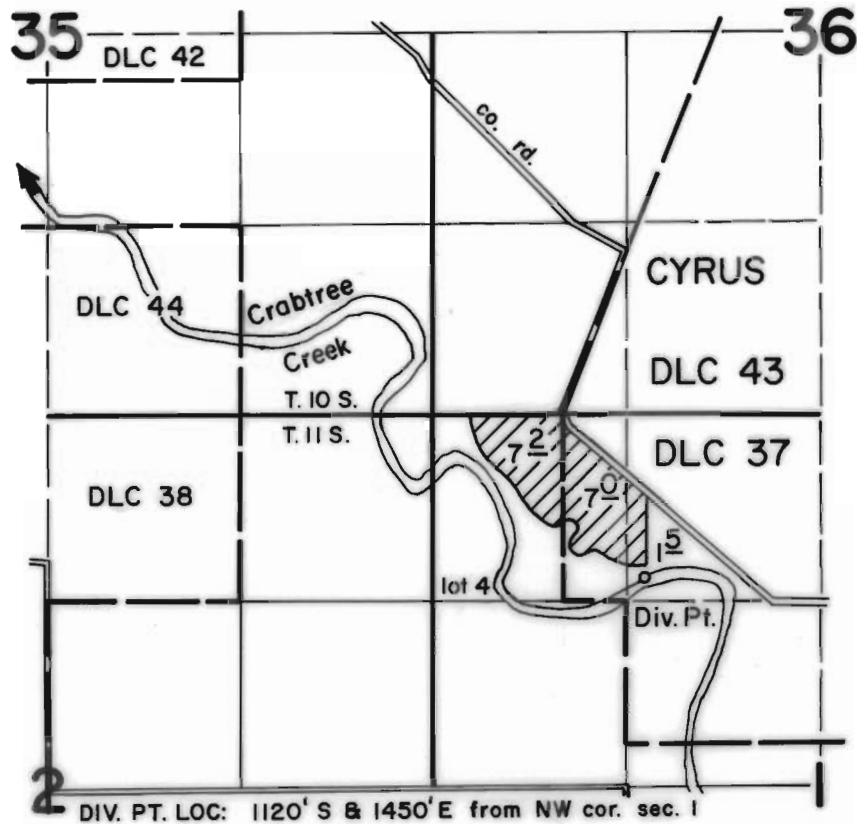

## FINAL PROOF SURVEY UNDER

Application No. 48083 Permit No. 36064  
IN NAME OF

GEORGE A. & REVA JENDRESEN

Surveyed April 2 1976, by D. Norby