


T.13S., R.1W., W.M.

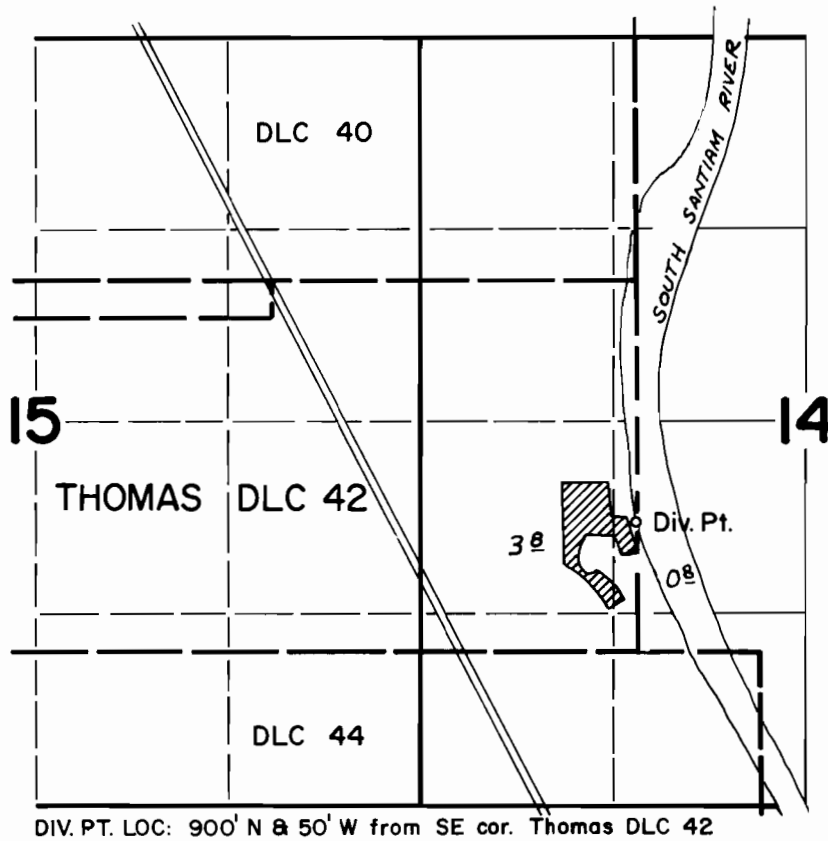

FINAL PROOF SURVEY UNDER


Application No. 48965 Permit No. 36666
IN NAME OF

DAVID K. & MARY I. BOWMAN

Surveyed Oct. 21 1976, by D. Norby

T. 13 S., R. 1 W., W.M.

NOT CORRECT BY L.D.

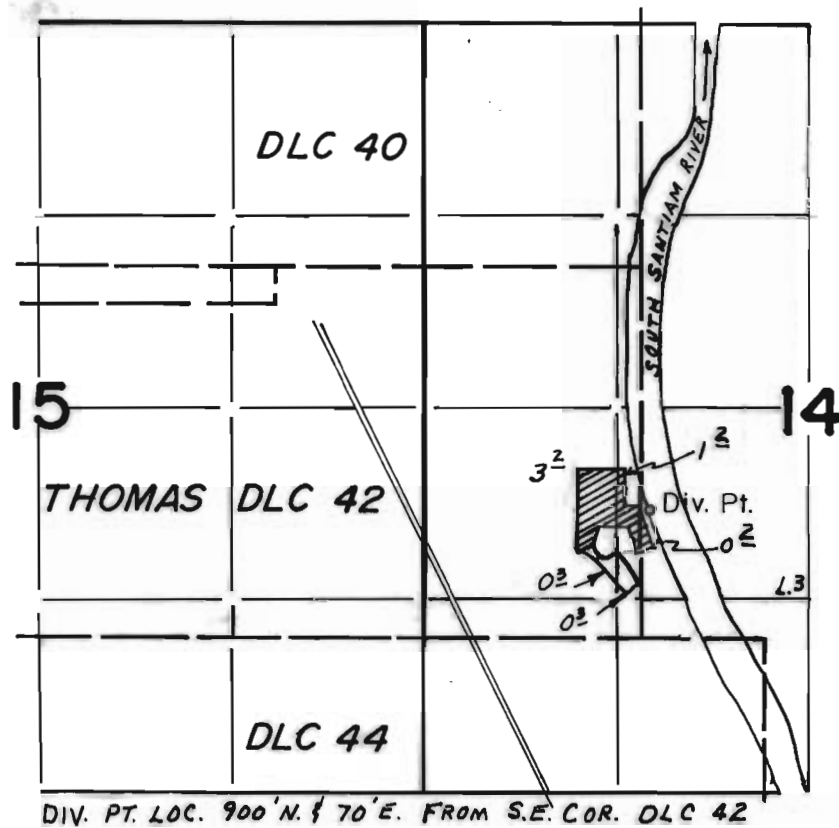

FINAL PROOF SURVEY
UNDER

Application No. 48965 Permit No. 36666
IN NAME OF

DAVID K. & MARY L. BOWMAN

Surveyed OCT. 21, 1976 by D. NORBY