


T.14S., R.1E., W.M.

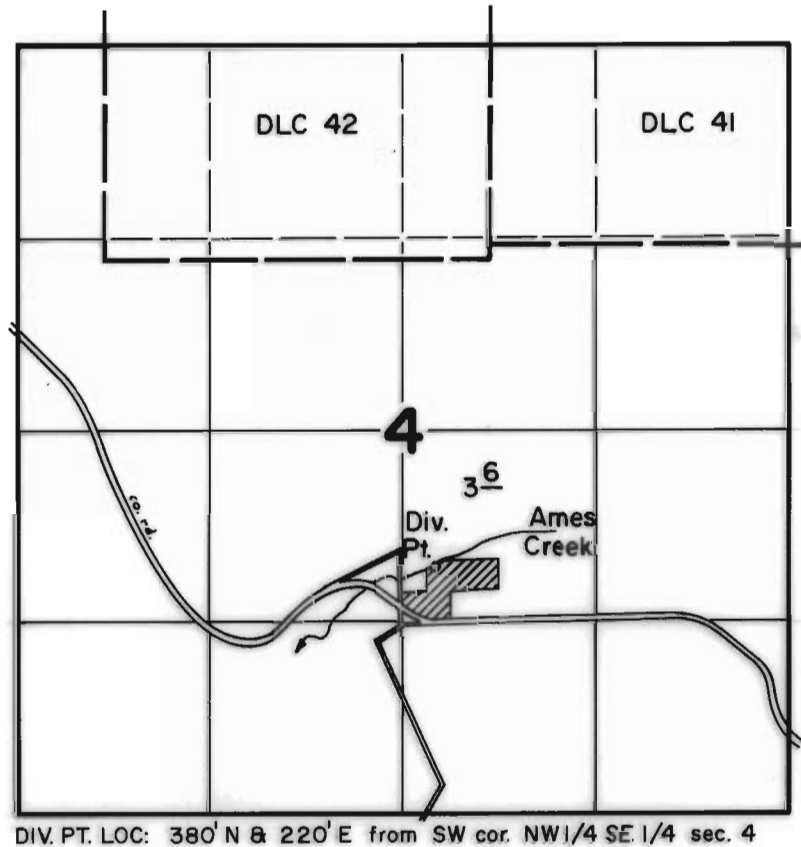

FINAL PROOF SURVEY
UNDER

Application No. 49538 Permit No. 37078
IN NAME OF

O. E. & FLORENCE M. LeGRAND

Surveyed May 3 1976, by D. Norby