


T.9S.,R.1W.,W.M.

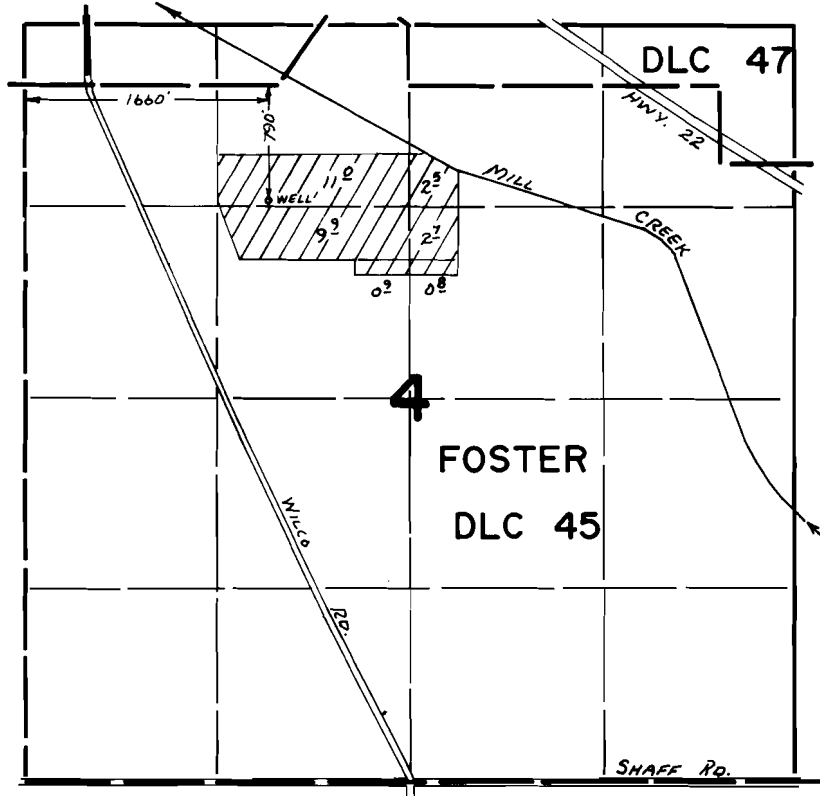

FINAL PROOF SURVEY
UNDER

Application No. ...G:5412.. Permit No. ...G:5345.
IN NAME OF

.....**ANTON MACK**.....

Surveyed July...9... 1976, by L. TOLL.....