


# T.8S.R.2W.W.M.

B. MUNKERS DLC 52

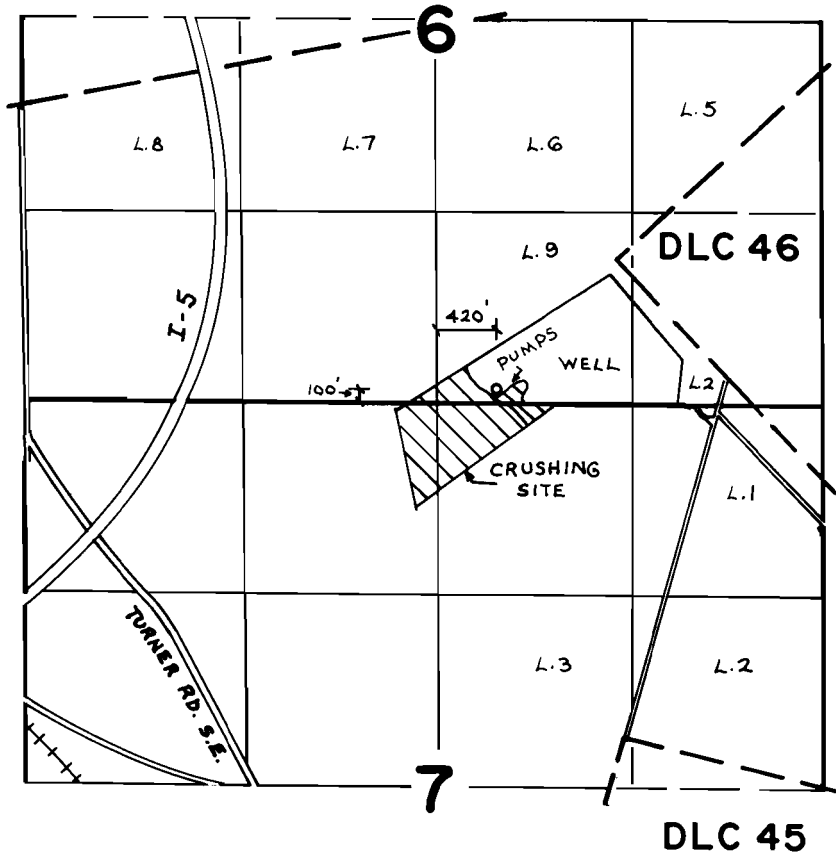

## FINAL PROOF SURVEY UNDER

Application No. G-5469 Permit No. G-5377  
IN NAME OF

MARION - POLK MATERIALS CORP.

Surveyed Aug. 6 1976, by R.G. Mucken