


T.9S.,R.1E.,W.M.

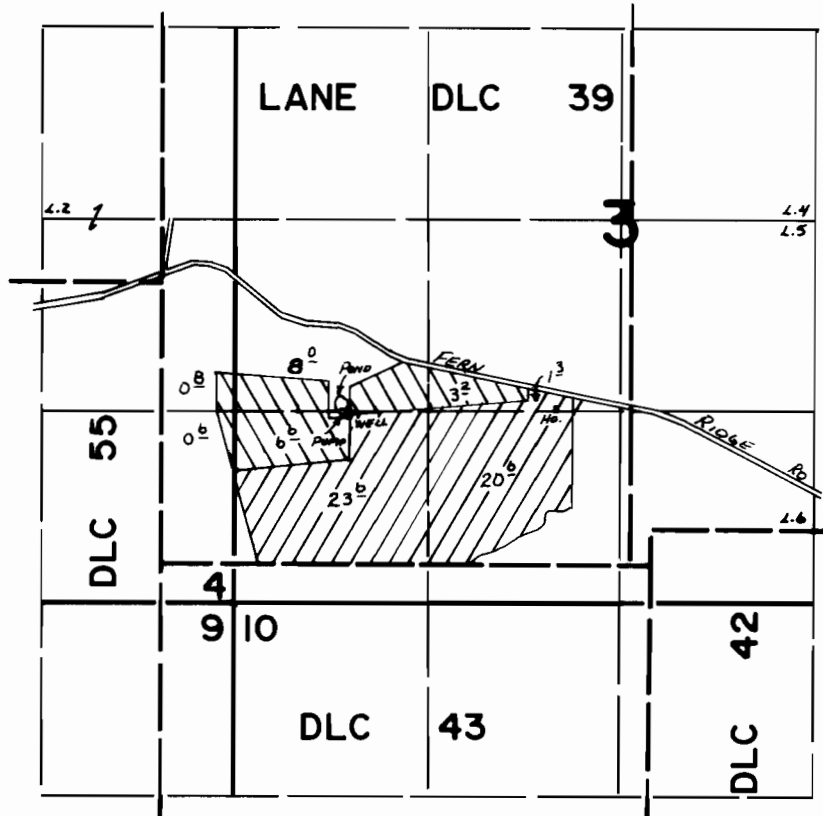

WELL Loc: 1020' N AND 1240' E FROM SW COR. LANE DLC 39



FINAL PROOF SURVEY UNDER

Application No. G-5829 Permit No. G-5576
IN NAME OF

ETZEL BROTHERS

Surveyed JULY 8 1976, by L. TOLL