


T.6S.R.2W.W.M.

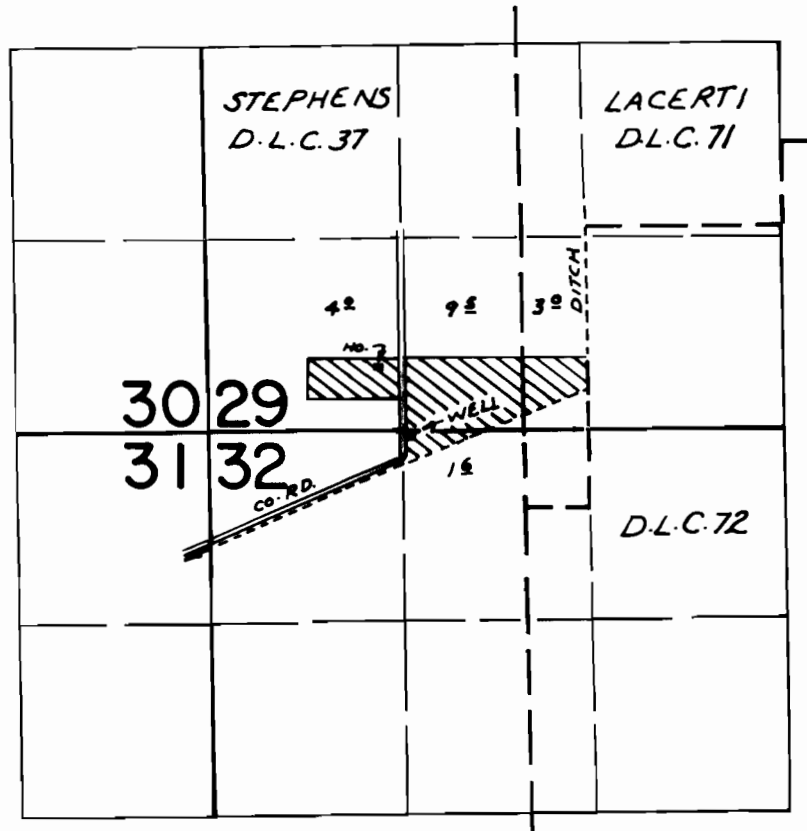

WELL LOC: 500' N. & 780' W. FROM S.W. COR. D.L.C. 71

FINAL PROOF SURVEY
UNDER

Application No. G-5979 Permit No. G-5706
IN NAME OF

ESTATE OF RONALD E. JONES

Surveyed AUG. 2, 1976, by R. MUCKEN