


T.9S.,R.IW.,W.M.

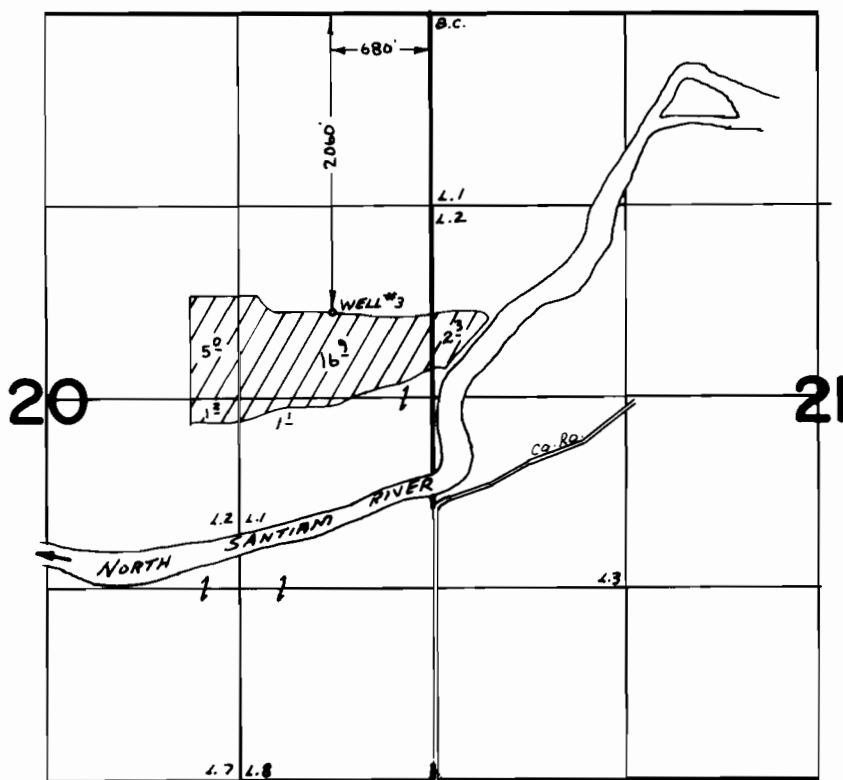

FINAL PROOF SURVEY
UNDER

Application No. G-6027 Permit No. G-5714
IN NAME OF

DORSEY B. GRAY

Surveyed July 6, 1976, by L. Toll