


T.7S.,R.2W.,W.M.

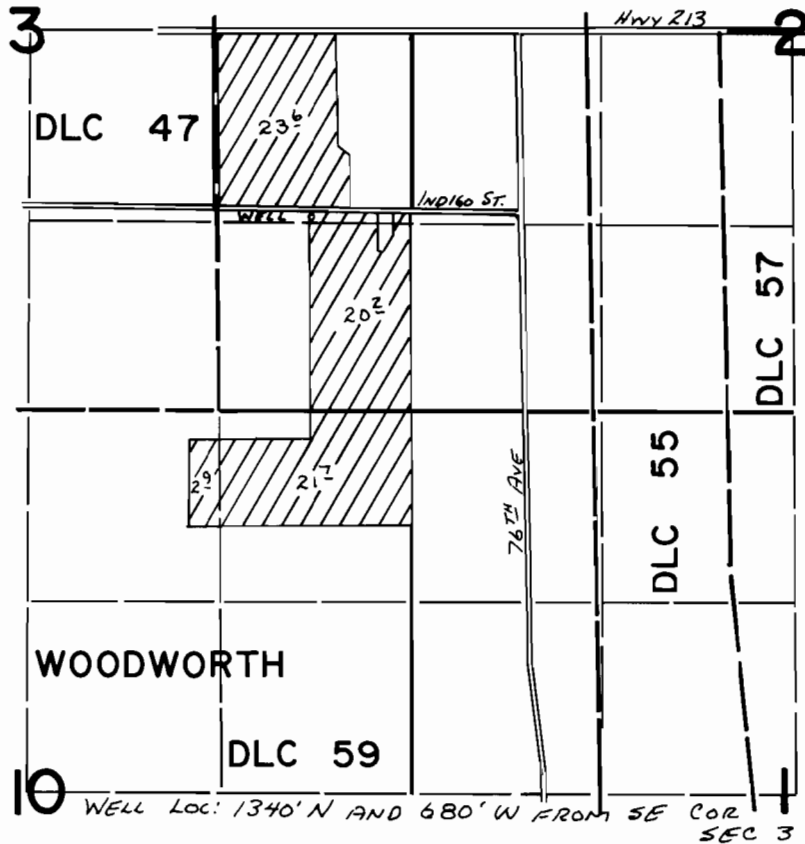

FINAL PROOF SURVEY UNDER

Application No. G-6523 Permit No. G-6134
IN NAME OF

LEONARD W. ROTH

Surveyed May 21 1976, by L. Tolk