


# T.6S.R.2W.W.M.

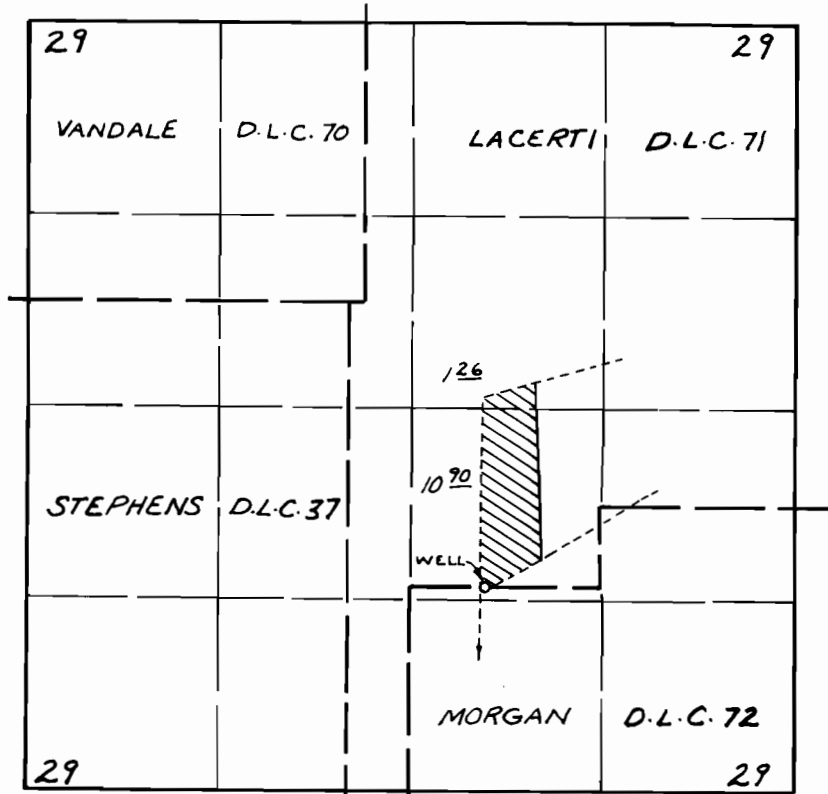

WELL LOC: 1950' S. & 830' E. FROM S.E. COR. D.L.C. 70

## FINAL PROOF SURVEY UNDER

Application No. G-6676 Permit No. G-6228  
IN NAME OF

RONALD E. JONES, JR.

Surveyed AUG. 2, 1976, by R. MUGKEN