


T.6S.,R.1&2W.,W.M.

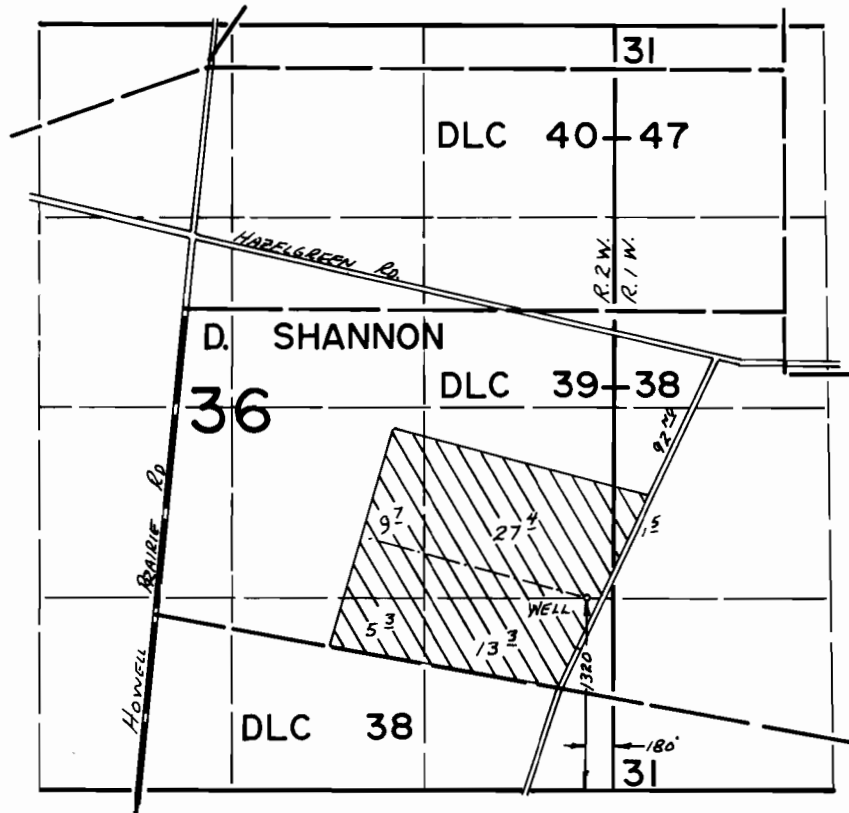

**FINAL PROOF SURVEY**  
UNDER

Application No. G-6821 Permit No. G-6321...  
IN NAME OF

MALLORIES DAIRY, INC.

Surveyed Aug. 9, 1976, by L. TOLL