


T.7S.,R.1E.,W.M.

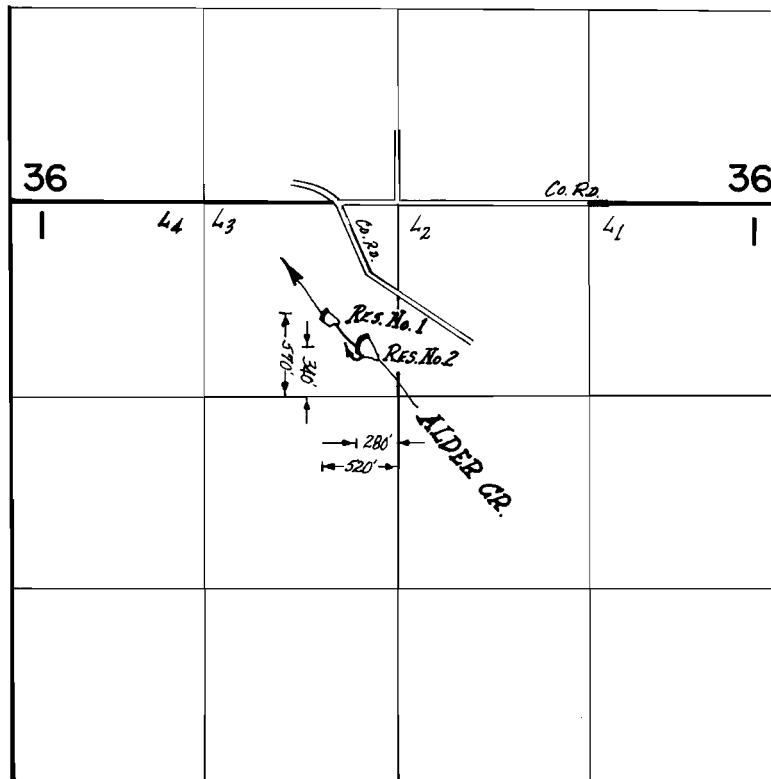

FINAL PROOF SURVEY
UNDER

R-50921 R-6196
Application No. 50922 Permit No. 38446
IN NAME OF

GARNER EVANS

Surveyed Sept. 9 1977, by R.G. Mucken