


T.6S.,R.1W.,W.M.

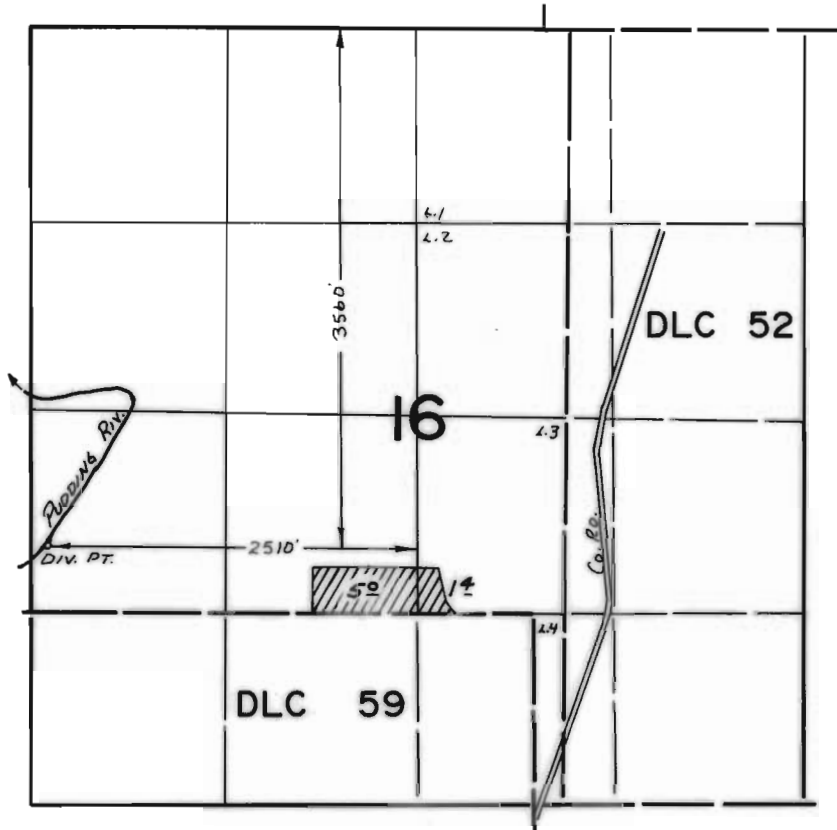

FINAL PROOF SURVEY UNDER

Application No. 51620 Permit No. 38933
IN NAME OF

ROBERT W. JOHNSON

Surveyed Aug. 13, 1976, by L. Toll