


T. 1N. R. 27E. W.M.

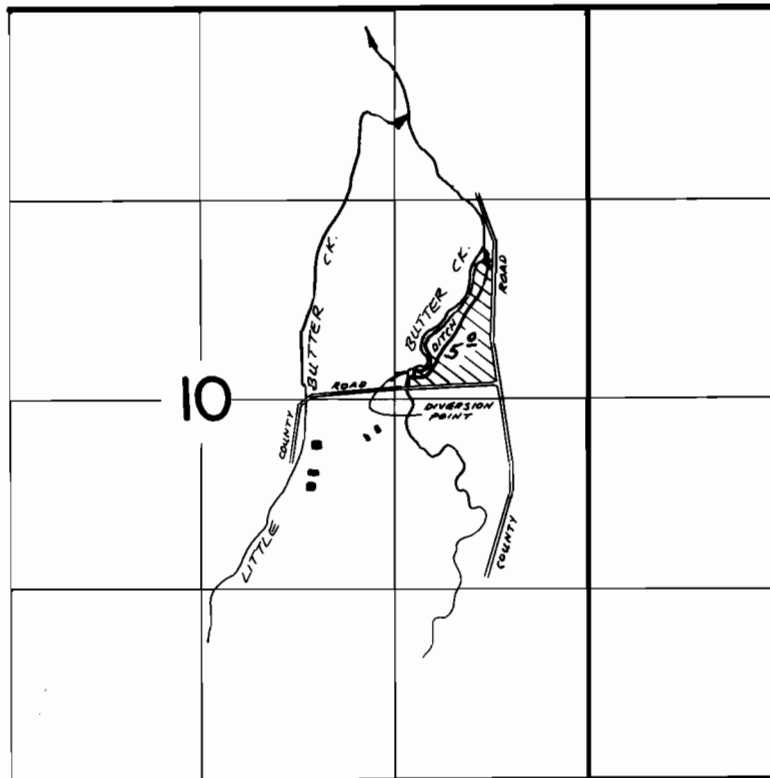

DIVERSION POINT LOCATED 160' N. & 1190' W. FROM E. 1/4 COR SEC 10

FINAL PROOF SURVEY
UNDER

Application No. 53803 Permit No. 40167
IN NAME OF

EARL W. WATTENBURGER c/o WELDON WITHERRITE

Surveyed FEB. 8. 1978, by R. BARWIN