


T.1N.R.2E.W.M.

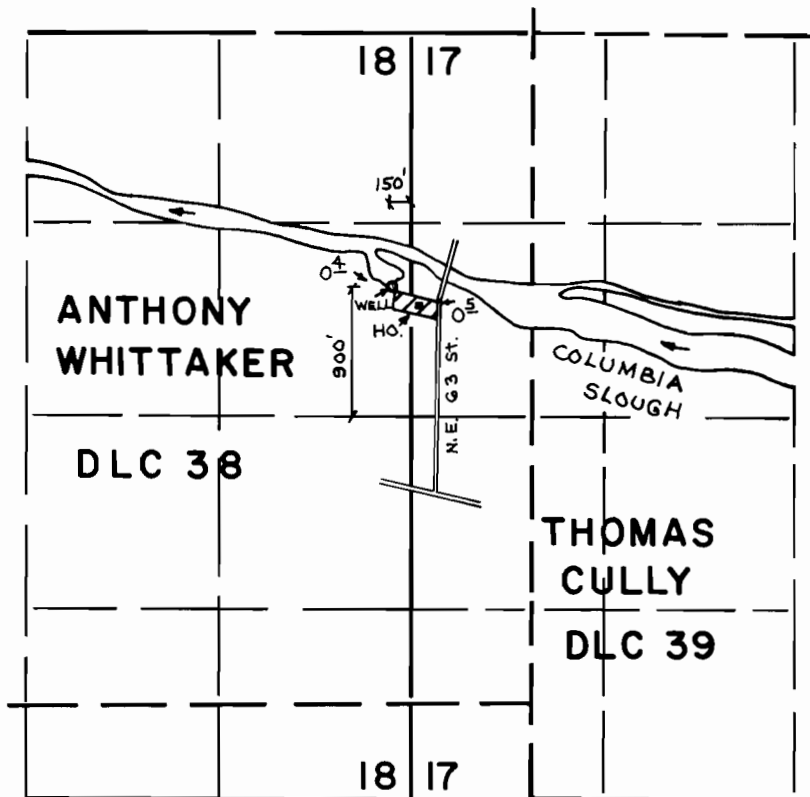

FINAL PROOF SURVEY
UNDER

Application No. 51498 Permit No. 38868
IN NAME OF

ARTHUR E. FISHER

Surveyed July 8 1976, by R.G. Musken