


T. 9 S. R. 5 W. W.M.

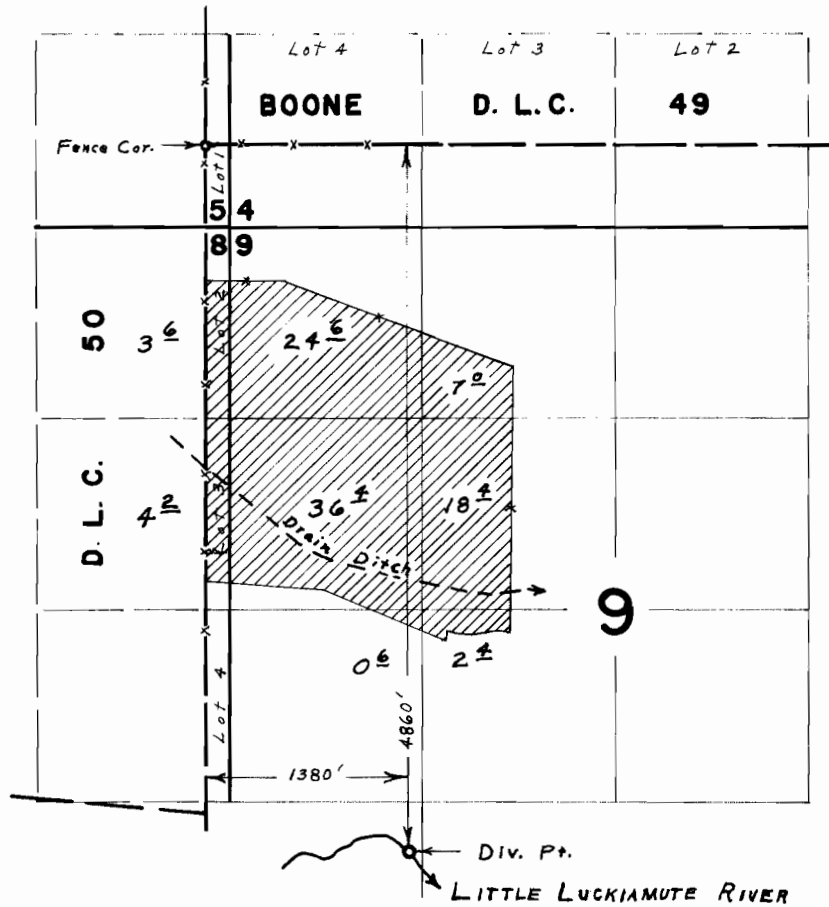

FINAL PROOF SURVEY UNDER

Application No. 41817... Permit No. 31301...
IN NAME OF

CLARE MILLHOUSER

Surveyed **March 18, 1969**, by **L. E. Gould**