


T.3S., R.9W., W.M.

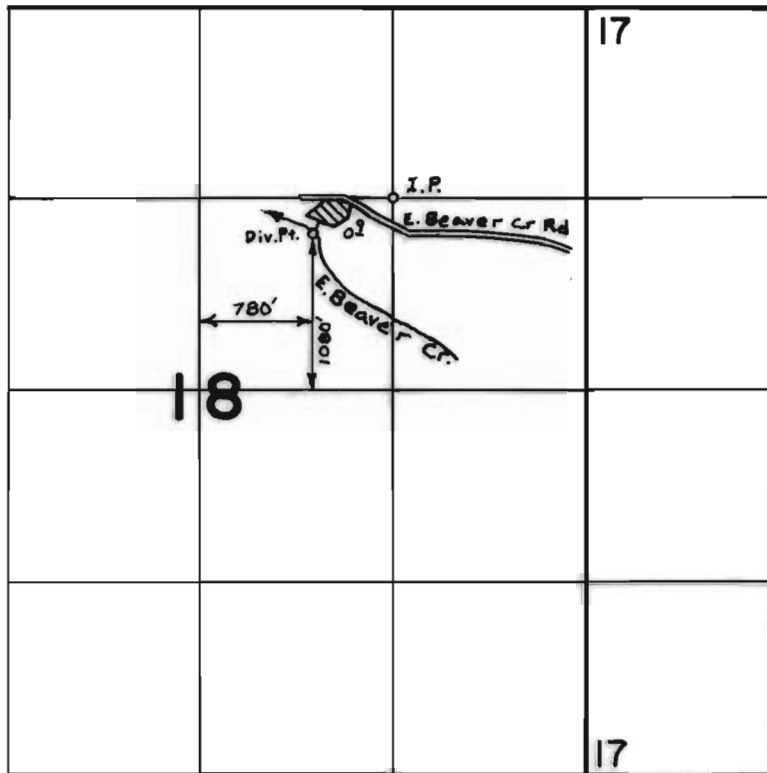

FINAL PROOF SURVEY UNDER

Application No. 49515 Permit No. 37362
IN NAME OF

JAMES R. & LAURA FOX

Surveyed JUNE 25 1976, by D. NORBY