


T.4 S., R.10W., W.M.

SEC. 2

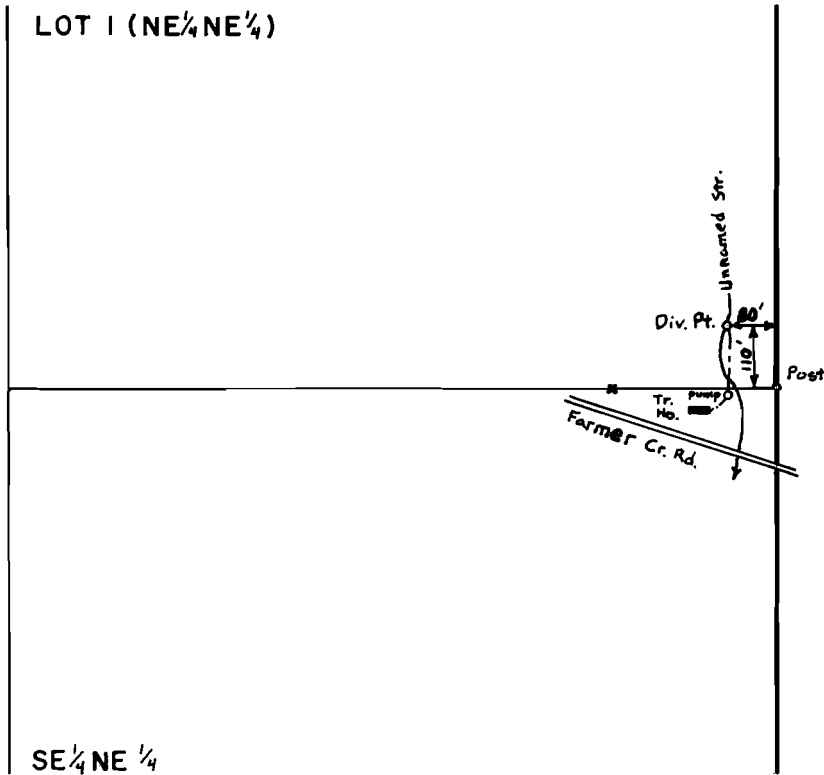

1" = 330'

**FINAL PROOF SURVEY**  
UNDER

Application No. 49912 Permit No. 37560  
IN NAME OF

..... STEVEN WILLIAMS .....

Surveyed JUNE 23 1976, by D. NORBY .....