


T.3S., R.9W., W.M.

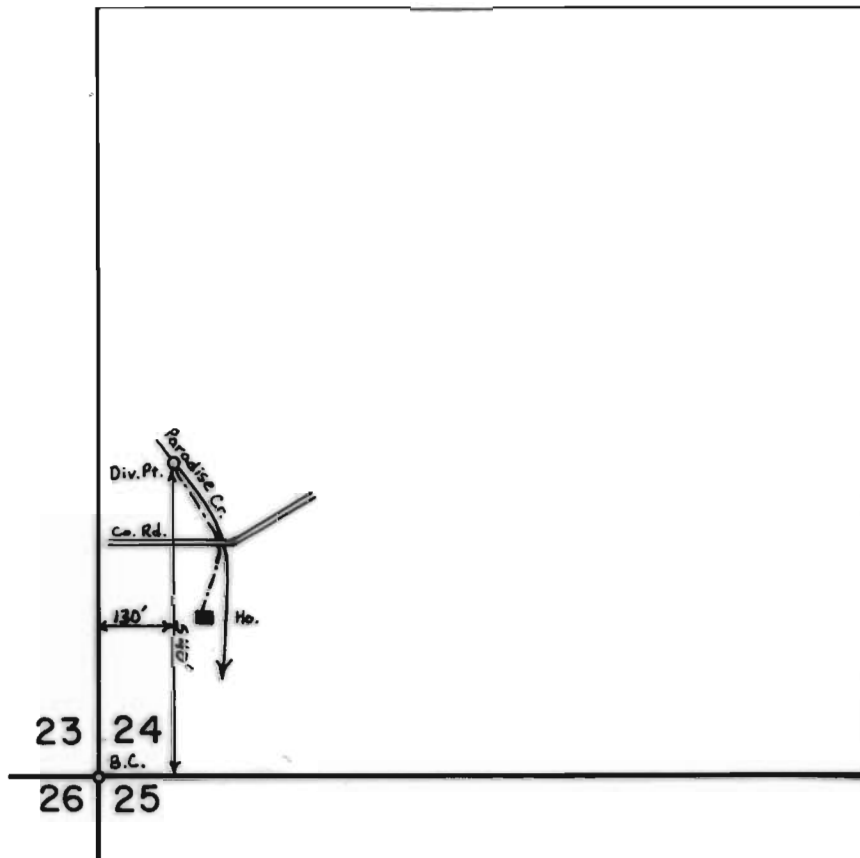

SCALE: 1" = 330'

FINAL PROOF SURVEY
UNDER

Application No. 51673 Permit No. 38960
IN NAME OF

HELEN E. SMITH

Surveyed JUNE 25 1976, by D. NORBY