


T.2S.,R.9W.,W.M.

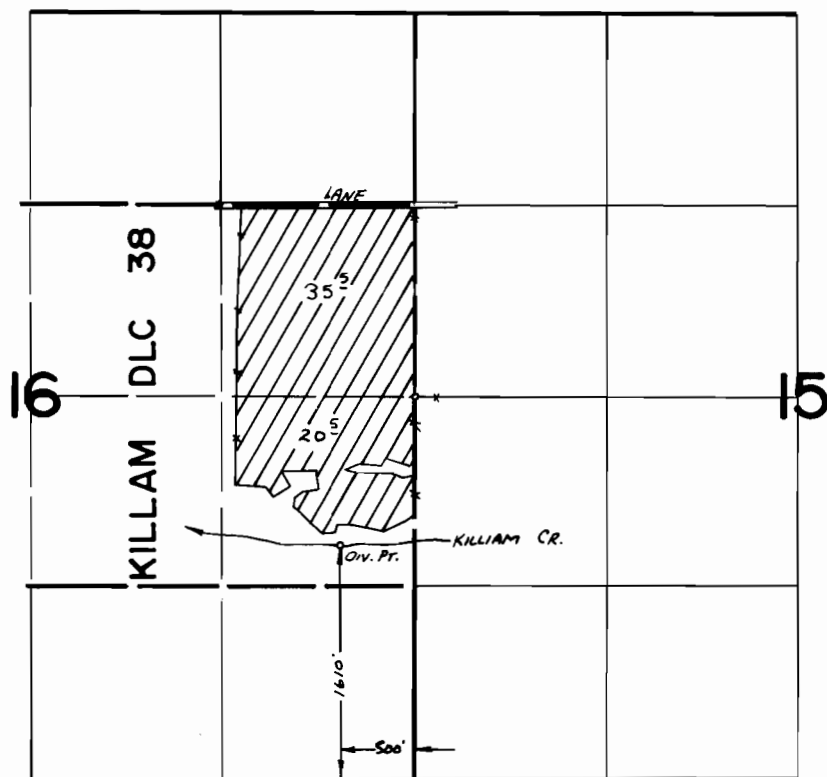

FINAL PROOF SURVEY
UNDER

Application No. 51948 Permit No. 39078
IN NAME OF

GEORGE E. MILNE

Surveyed JUNE 28 1976, by L. TOLL