


T.2S.,R.9W.,W.M.

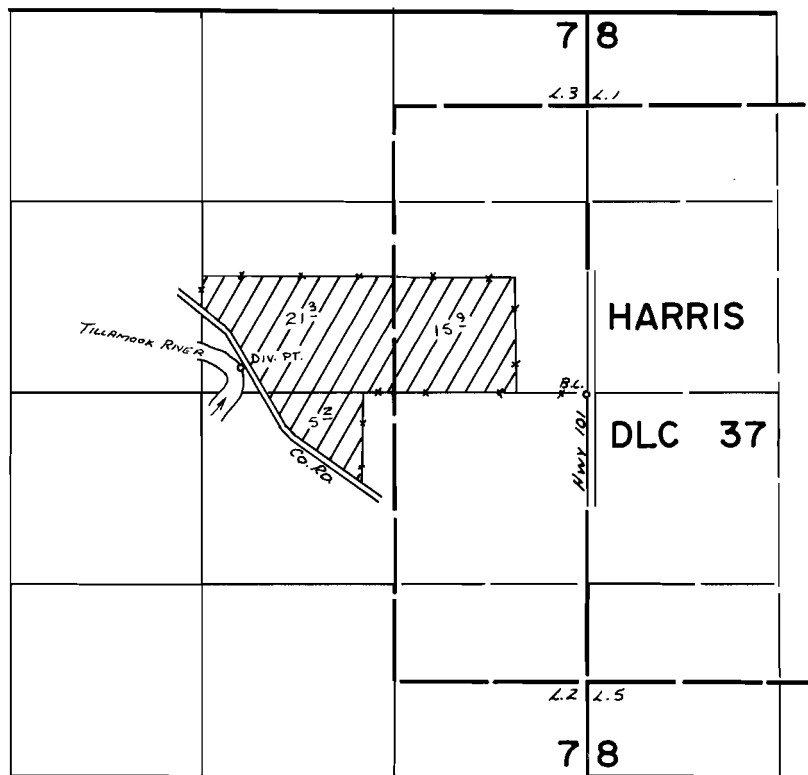

Div. Loc: 170' N AND 2380' W FROM E 1/4 COR. SEC. 7

FINAL PROOF SURVEY UNDER

Application No. 53278 Permit No. 39536
IN NAME OF

WM. DALE BUCK

Surveyed JUNE 28 1976, by L. TOLL