


B 4944  
46623

# T. 4N. R. 27 & 28E. W.M.

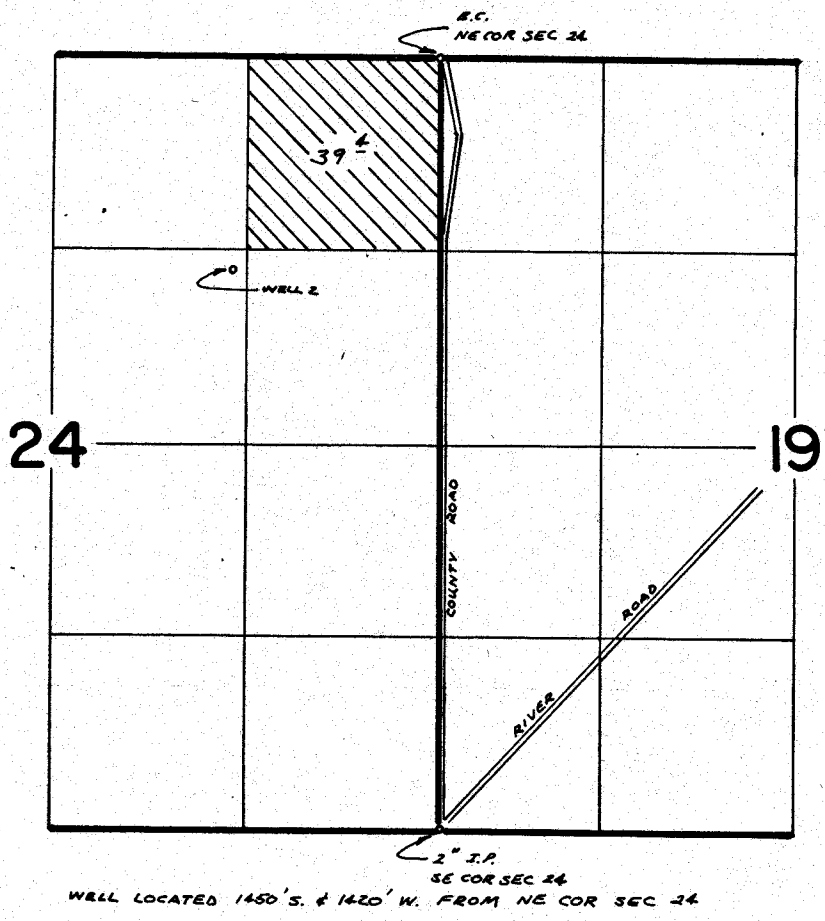

## FINAL PROOF SURVEY UNDER

Application No. G. 5710... Permit No. G. 4944...  
IN NAME OF  
.....RONALD BAKER.....  
Surveyed NOV 29 1977, by R. BARWIN.....