


G 6644
46627

T. 1S. R. 32E. W.M.

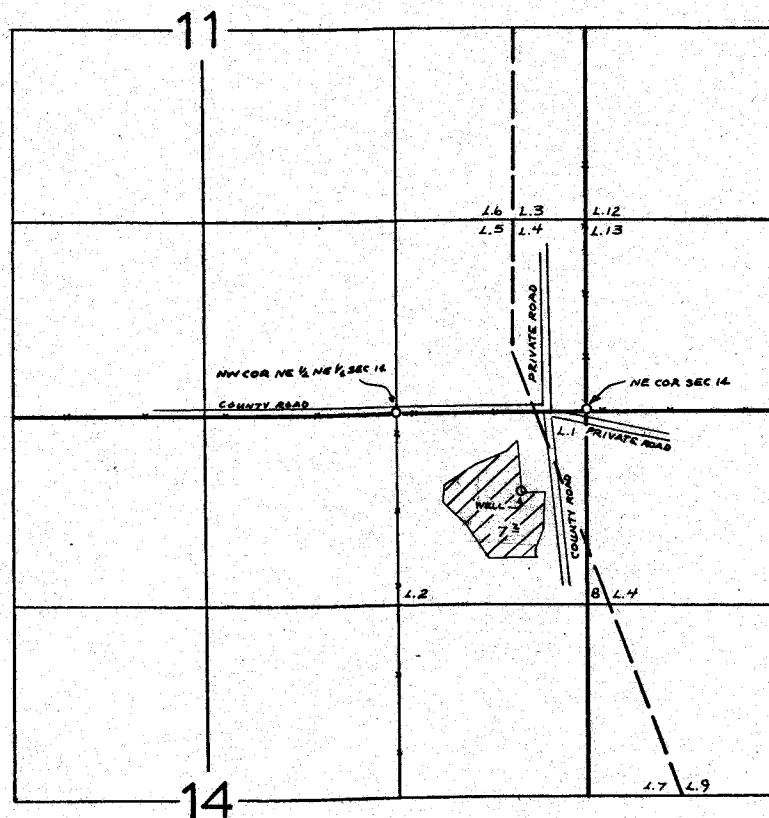

WELL LOCATED 530' S. & 150' W. FROM NE COR SEC 14

FINAL PROOF SURVEY UNDER

Application No. G.7234. Permit No. G.6644.
IN NAME OF

WILLIAM L. FUTTER

Surveyed OCT. 3. 1977, by R. BARWIN

PTS-1977-S-8
10/7/77 RFB