


T.6S., R.39E., W.M.

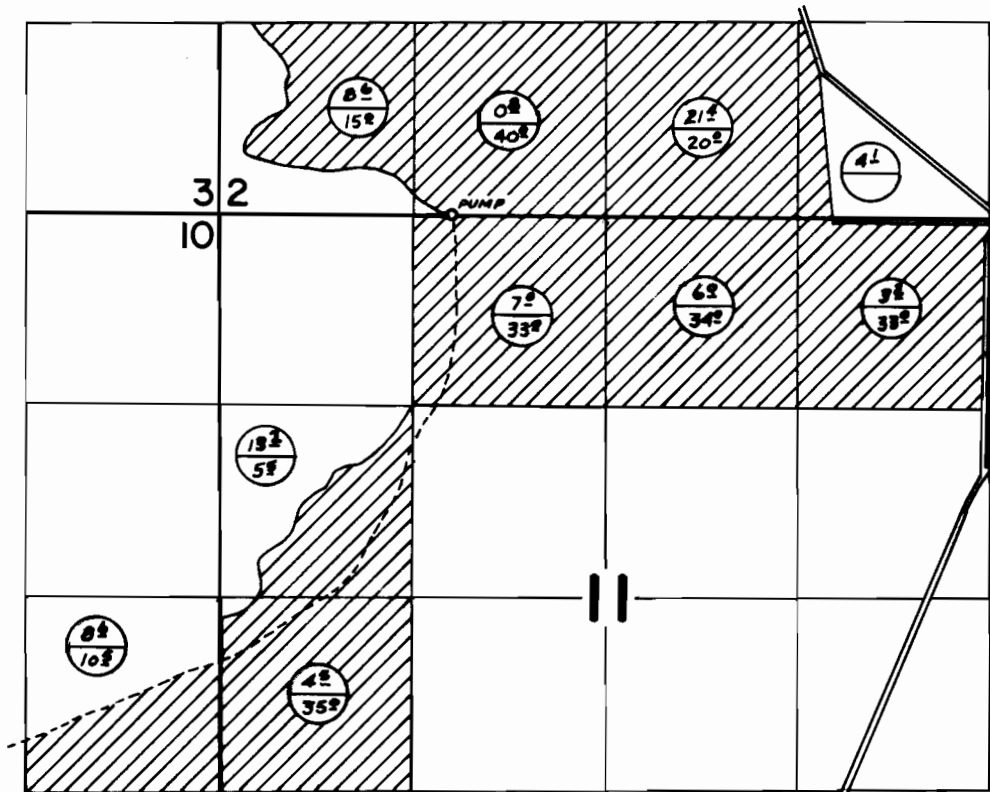

 THIS PERMIT
PRIOR SURFACE WATER RIGHTS

FINAL PROOF SURVEY UNDER

Application No. 47293 Permit No. 35435
IN NAME OF

EUGENE C. AND FRANCES McINTYRE

Surveyed Sept. 23 1976, by D. Norby