


G-7059
466-50

T.4N. R29E. W.M.

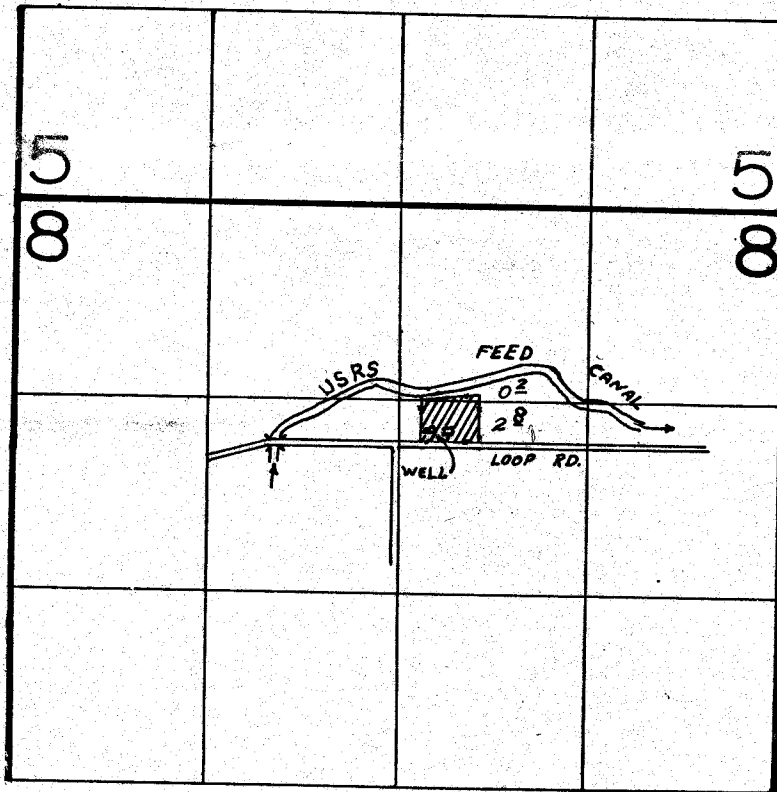

WELL LOCATED 1120'N & 220'E FROM CEN. OF SEC. 8

FINAL PROOF SURVEY
UNDER

Application No. G-7613. Permit No. G-7059
IN NAME OF

.....LAWRENCE BEHRENTZ.....

Surveyed FEB. 16. 1978, by B. BARWIN.....