


T. 4 S., R. 38 E., W.M.

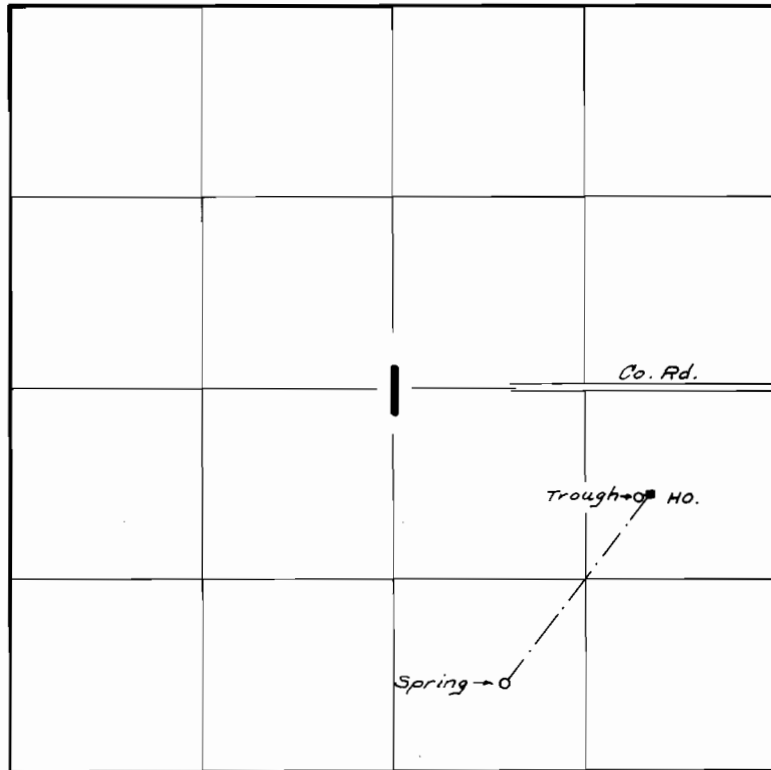

Spring Loc.: 600' N. & 760' E. from $5\frac{1}{4}$ Cor. Sec. 1

FINAL PROOF SURVEY UNDER

Application No. 53154 Permit No. 38782
IN NAME OF

John W. Boothman

Surveyed Sept 28, 1976, by D.M. Norby