


T.2N.R.14E.W.M.

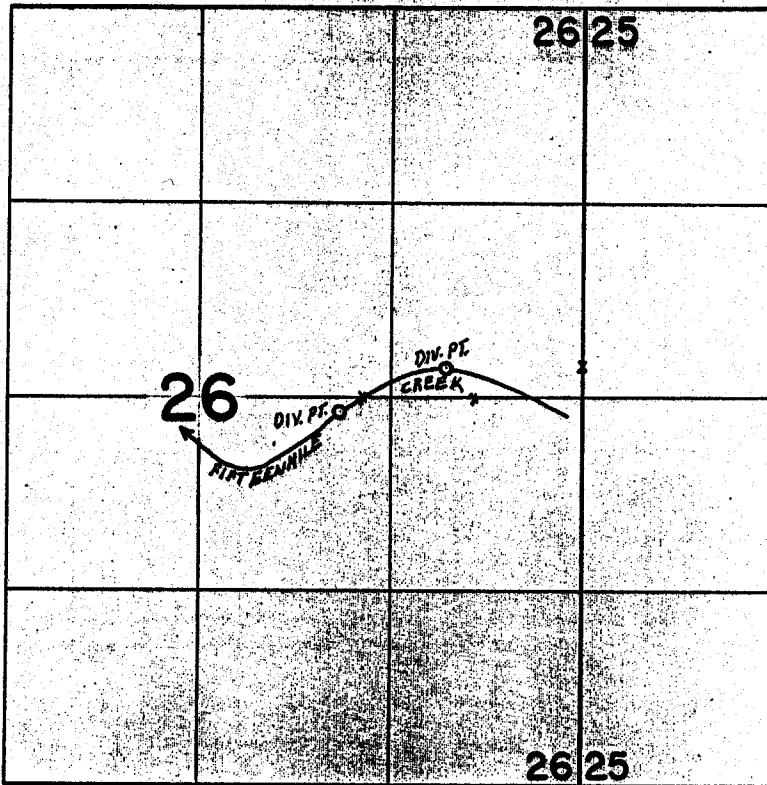

DIV. PTS. LOC. 100'S. & 76.60' W. ; 200' N. & 99.0' W. ; BOTH FROM E. 1/4 COR. SEC. 26

FINAL PROOF SURVEY UNDER

TRANSFER NO. K-52

Application No. _____ Permit No. _____

IN NAME OF

CARL, JACOB, & JULIUS KASER

Surveyed OCT. 22, 1970, by L. E. GOULD