


T.2N.R.14E.W.M.

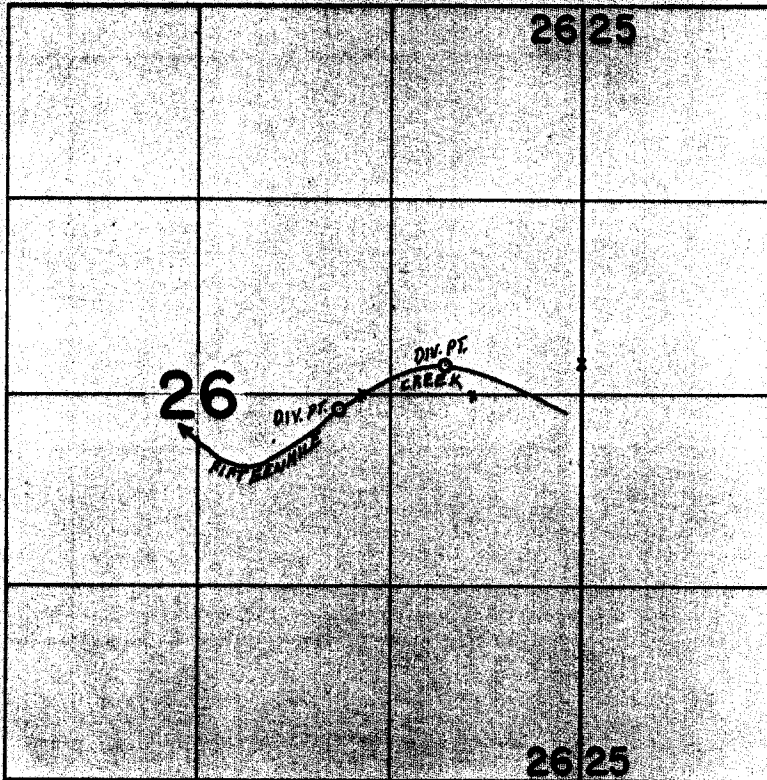

DIV. PTS. LOC. 100'S & 1660' W. ; 200' N. & 910' W. BOTH FROM
E 1/4 COR. SEC. 26

FINAL PROOF SURVEY
UNDER

TRANSFER NO. K-52

Application No. _____ Permit No. _____

IN NAME OF

CARL, JACOB, & JULIUS KASER

Surveyed OCT. 22, 1970, by L. E. GUILD