


P-37698
46645

T.8S., R.24E., W.M.

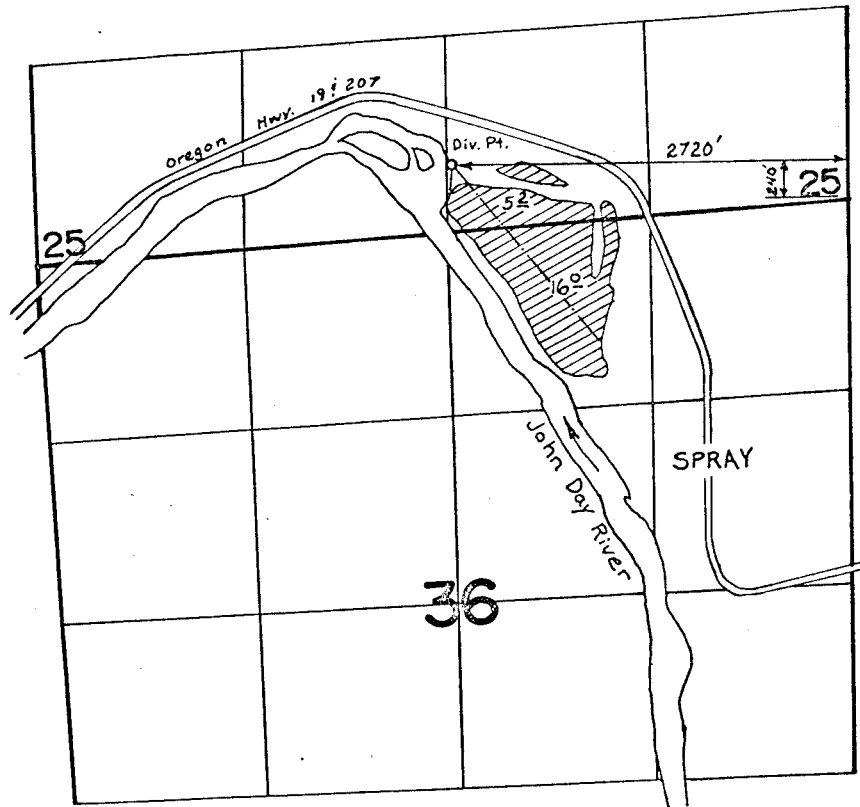

FINAL PROOF SURVEY UNDER

Application No. 50204 Permit No. 37698
IN NAME OF

HUBERT ASHER

Surveyed AUG. 21 1976, by D. NORBY