


# T.12S., R.21E., W.M.

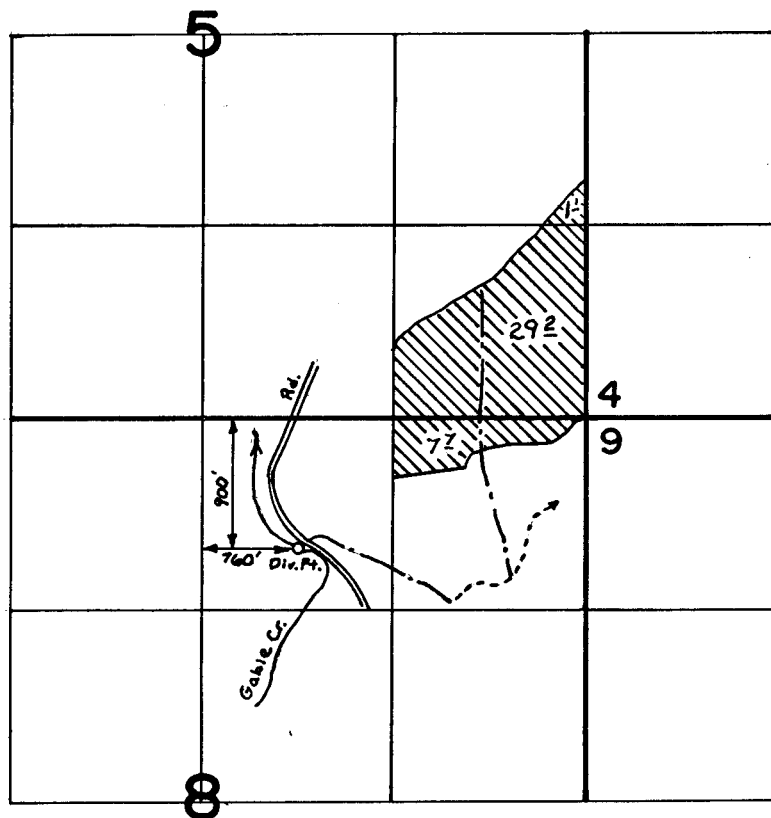

## FINAL PROOF SURVEY UNDER

Application No. 52656 Permit No. 39680  
IN NAME OF

KENNETH TAYLOR

Surveyed AUG. 19 1976. by D. NORBY