


P- 39721
46647

T.9S., R.25E.,W.M.

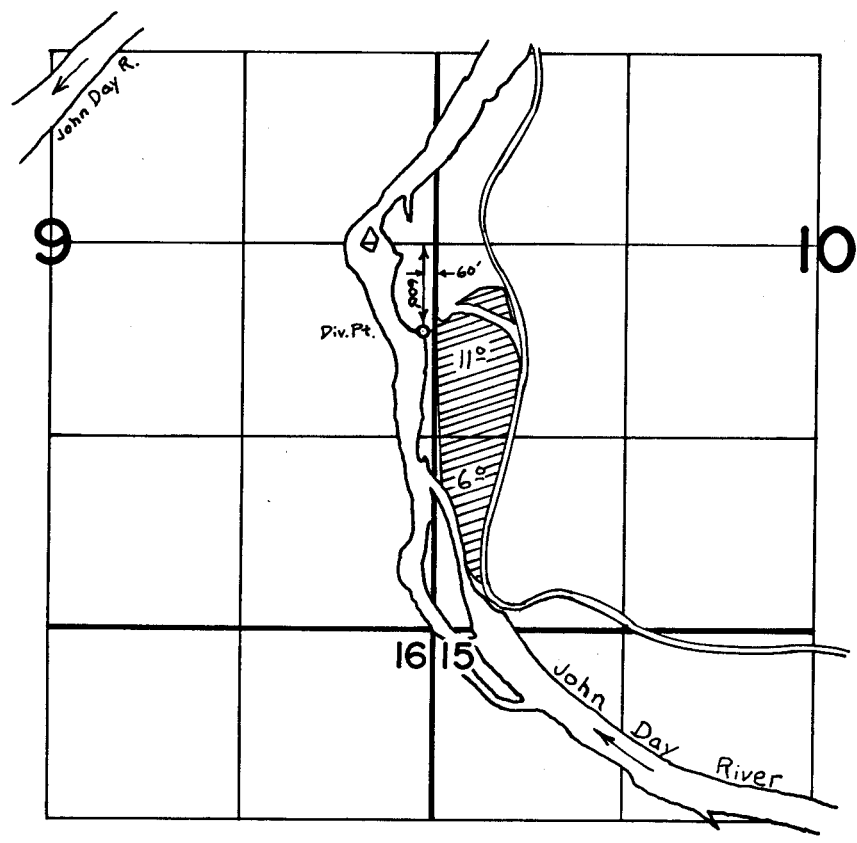

FINAL PROOF SURVEY UNDER

Application No. 52767 Permit No. 39721
IN NAME OF

DICK GRIFFITH

Surveyed AUG. 21, 1976, by D. NORBY