

6

5

7

8

18

17

15


14

13

22

23

24

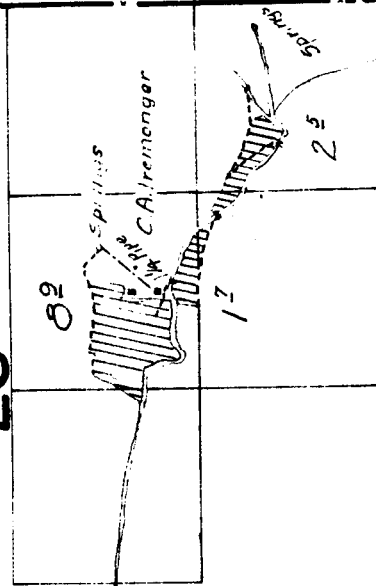

sketched in approximate
at in the vicinity of

27


26

25

34

35

36

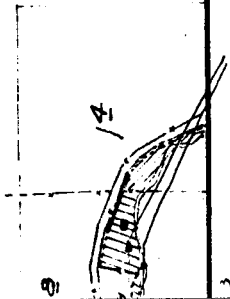

30

29

28

Lot 3
Lot 4

30° 23'

EU TIPLEY

Edwards & Cooke

0° 5'

17° 3'

27° 8'

6° 3'

31

32

FOSSIL 33

C. Johnson

101

CRELL

JOHN DAY HIGHWAY

COTTONWOOD

CL Prindle

0° 3'

Chas W. Morris

0° 2'

City Reservoir

865 x 65'

DEFLITY

Mrs. Nancy Clark

Cemetery

JAMM

Rocks end

JOHN DAY HIGHWAY

C. C. Busby

Surveyed Nov. 12, 14, 2

18


17

16

19

20

21

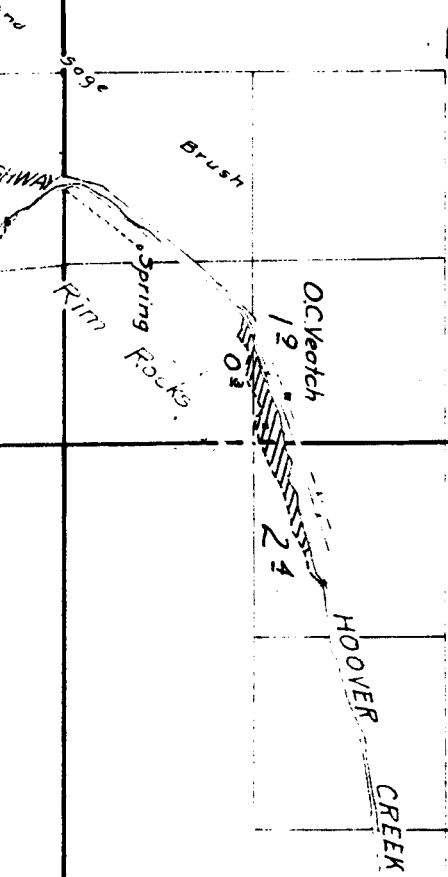

2

1

11


12

14

13

21

22

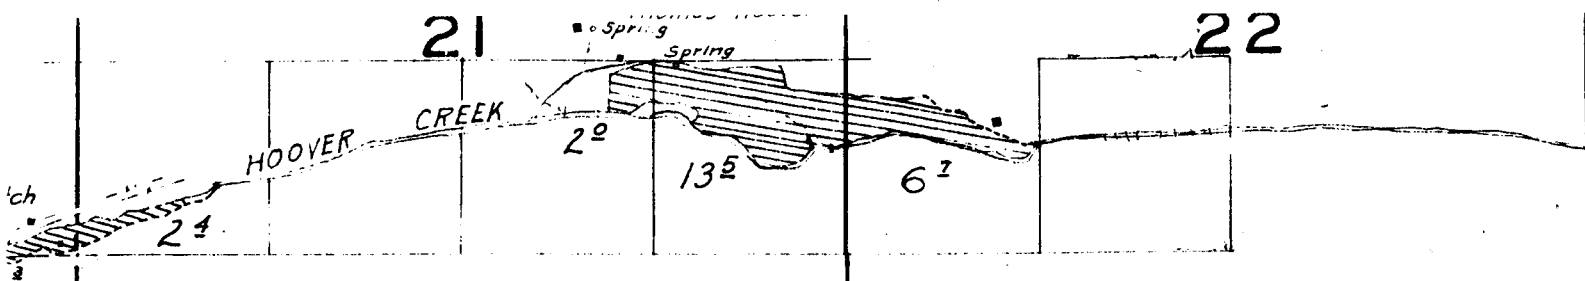

NOTE: Streams sketched in approximate location except in the vicinity of irrigated land.


28

27

Surveyed Nov. 12, 14, 20, & 21, 1925.

FOSSIL 33

34

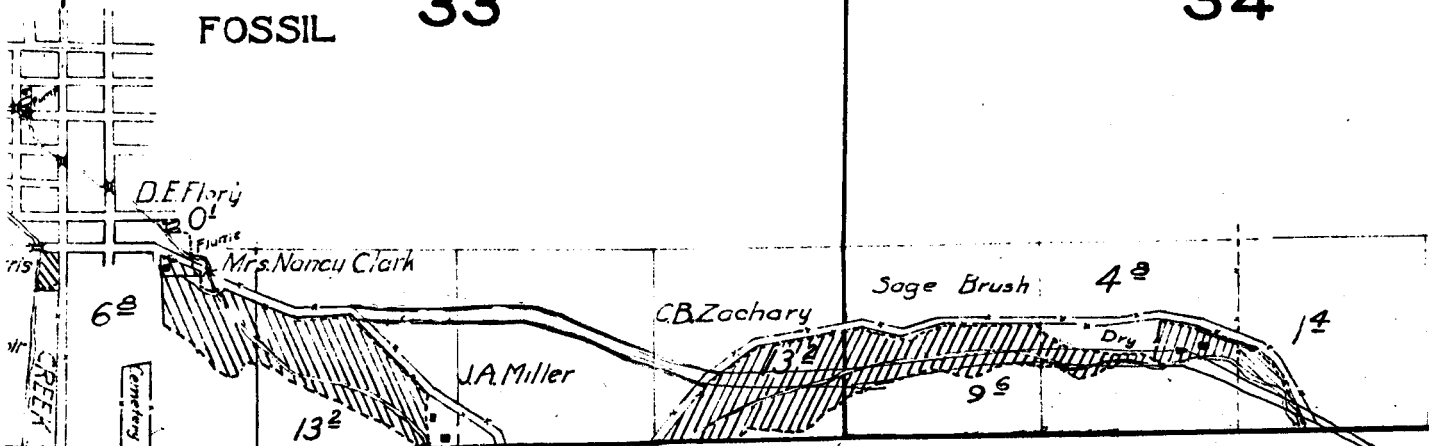


16

15

21

22

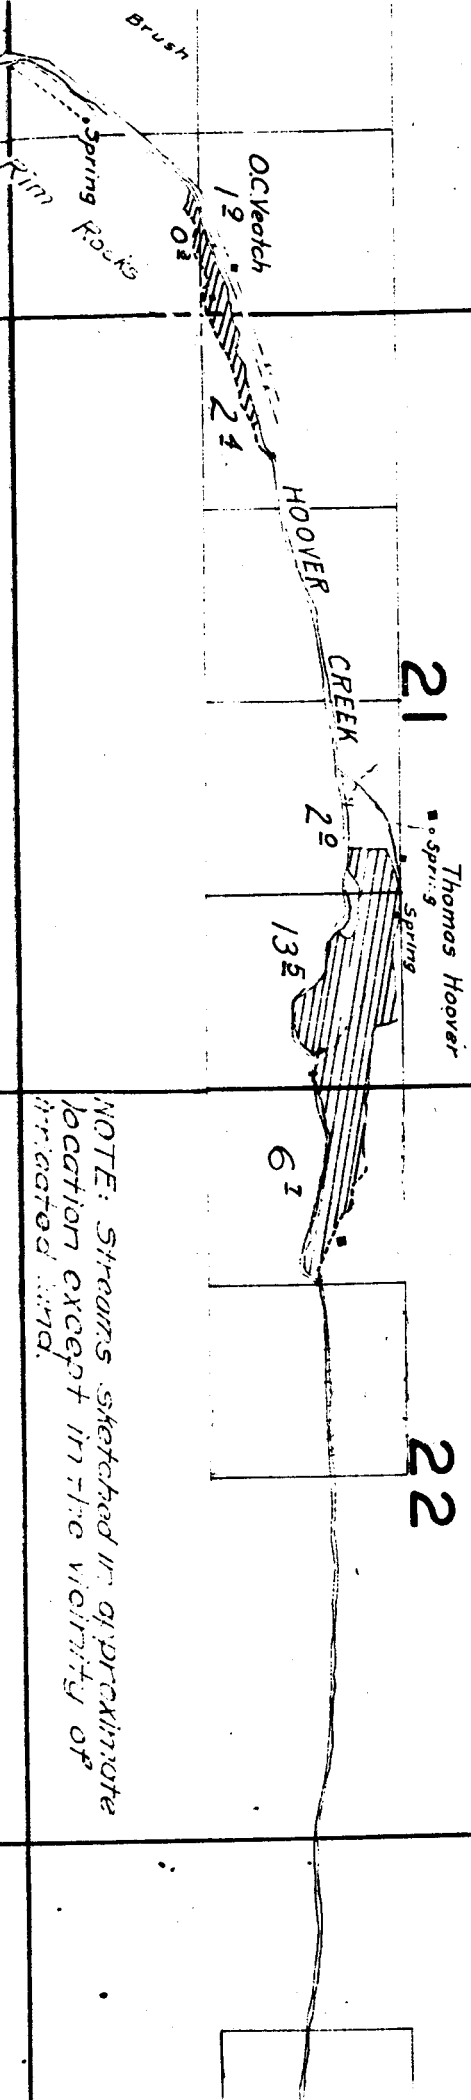

NOTE: Streams sketched in at approximate location except in the vicinity of indicated area.

TOWNSHIP 6 S. RANGE 21 E.

4


3

9

10

C-46648
M-173
SP 0- V16P 214
T-1439

T.7S. R.21E.W.M.

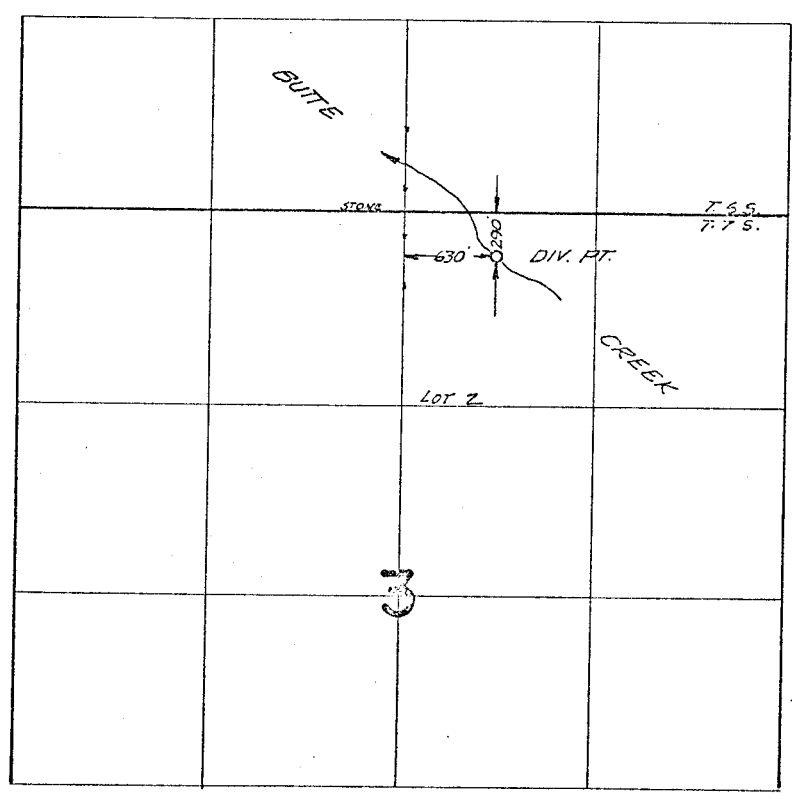

FINAL PROOF SURVEY
UNDER

TRANSFER M-173

Application No. Permit No.
IN NAME OF

.....EDGAR MYERS.....

Surveyed July 10, 1968, by V. Gerner.....