


T.5S., R.6W., W.M.

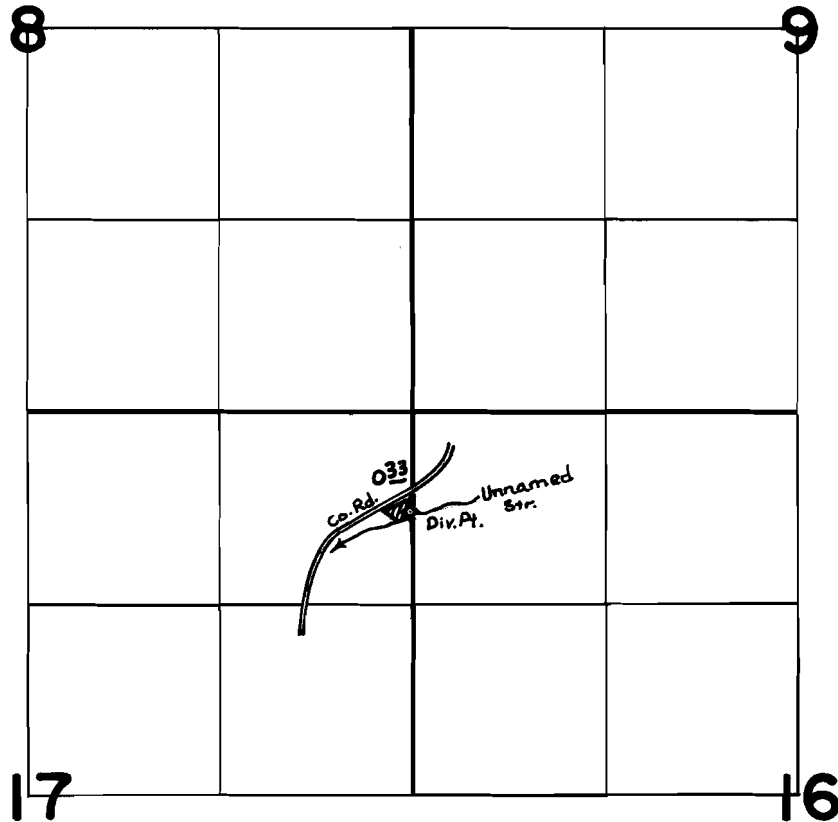

Div. Pt. Located: 680' S & 20' W from NE cor. Sec. 17

**FINAL PROOF SURVEY**  
UNDER

Application No. 53027 Permit No. 40021  
IN NAME OF

BILLIE L. KARLIN

Surveyed AUG. 4 1976, by D. NORBY