


T.6N. R.5W. W.M.

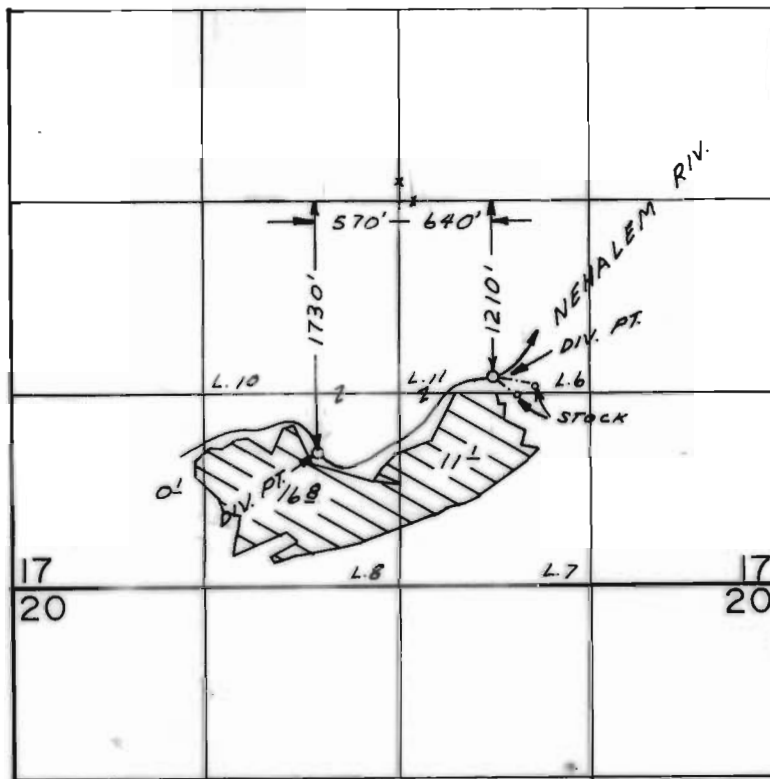

FINAL PROOF SURVEY
UNDER

Application No. 49839 Permit No. 37941
IN NAME OF

ROBERT G. & GLADYS DUPUIS

Surveyed JUNE 10, 1976, by L.H. NUNN