


T.27S., R.11W., W.M.

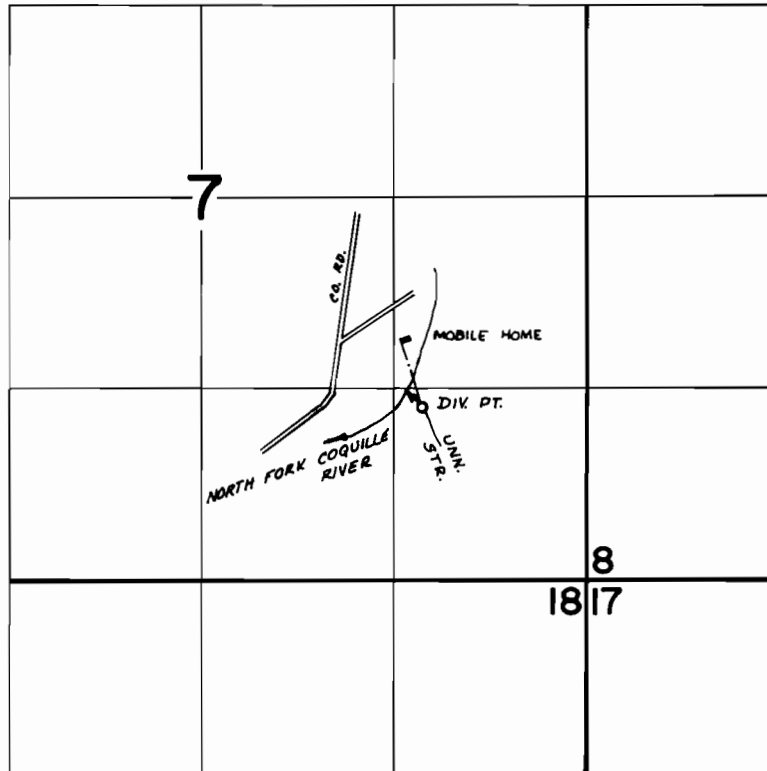

DIV. PT. LOC: 1190' N & 1130' W FROM SE COR. SEC. 7

**FINAL PROOF SURVEY**  
UNDER

Application No. 52742 Permit No. 39712  
IN NAME OF

.....JOSEPH B. & MILDRED M. CRESS.....

Surveyed July 17, 1976, by D. Norby.....