


C
46658

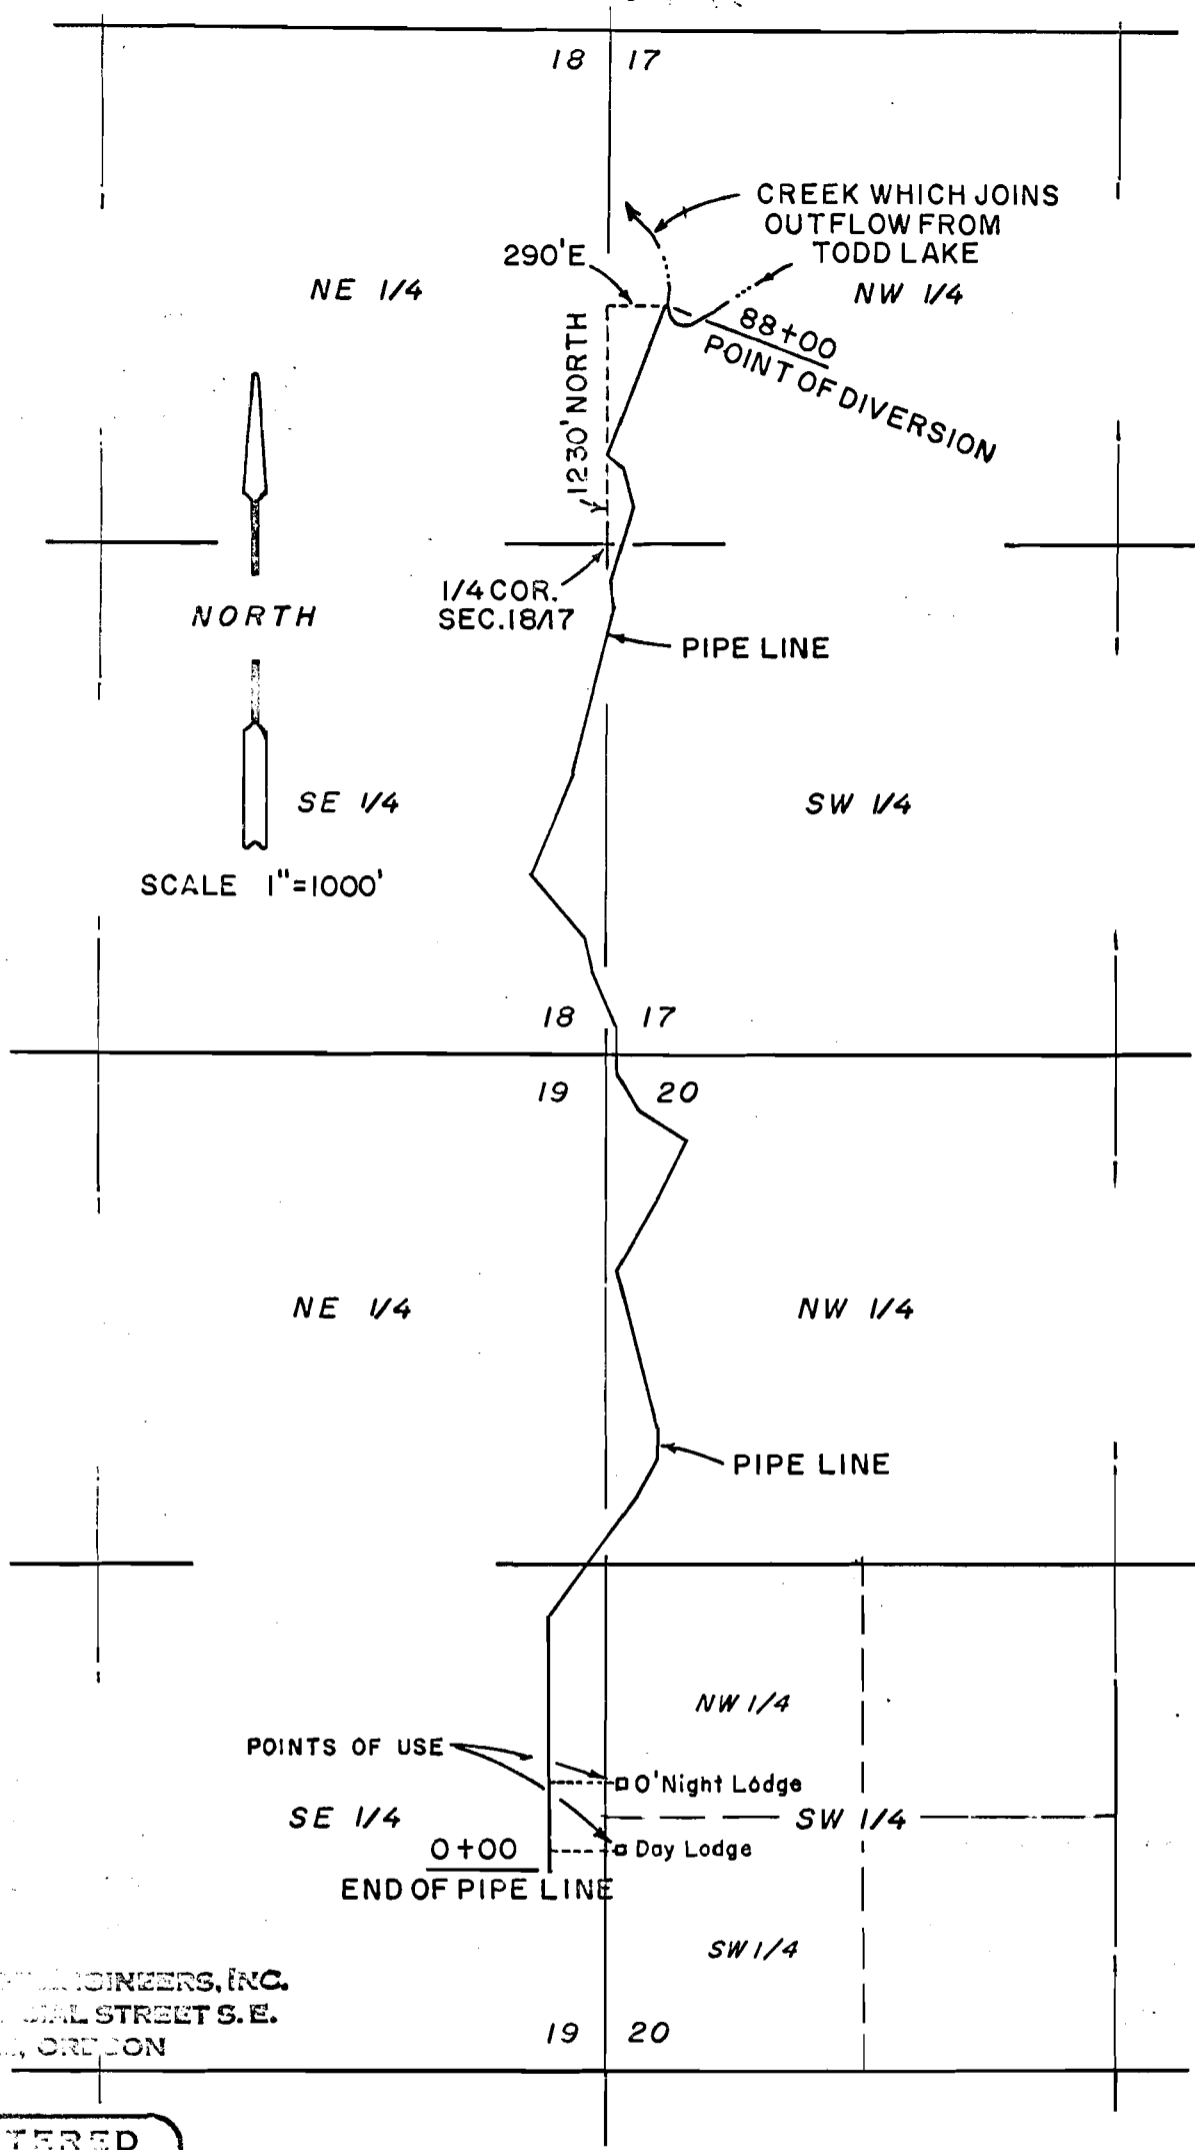

CLARK & GROSS ENGINEERS, INC.
 3276 COMMERCIAL STREET S. E.
 SALEM, OREGON

REGISTERED
 OREGON
 LAND SURVEYOR

August C. Ciering
 JULY 12, 1953
 AUGUST C. CIERING
 808

DIVERSION POINT & PIPE LINE LOCATION
 MT. BACHELOR INC.,
 SEC. 17, 18, 19 & 20, T18S, R9E, WM.
 DESCHUTES COUNTY, ORE.

J 0 64016 7 JAN 1966

Application No. 41859
 Permit No. 31125